


Give All Information Completely  
Make Required, Affidavit  
Mail or Deliver Report to:  
Conservation Division  
State Corporation Commission  
212 No. Market  
Wichita, Kansas

WELL PLUGGING RECORD

Meade County, Sec. 36 Twp. 32S Rge. 29W (E) (W)  
Location as "NE/CNW/SW" or footage from lines C/SW of SW  
Lease Owner HORIZON OIL & GAS CO.  
Lease Name Hallock "B" Well No. 1-36  
Office Address P.O. Box 7, Spearman, Texas 79081  
Character of Well (completed as Oil, Gas or Dry Hole) Gas  
Date well completed 5-20 19 66  
Application for plugging filed 3-18 19 83  
Application for plugging approved 6-13 19 83  
Plugging commenced 12-6 19 83  
Plugging completed 12-8 19 83  
Reason for abandonment of well or producing formation Depleted

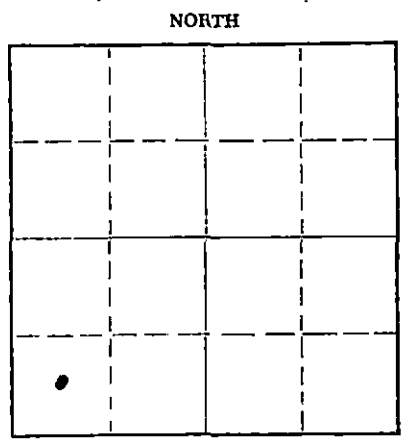

Locate well correctly on above Section Plat

If a producing well is abandoned, date of last production April 1983  
Was permission obtained from the Conservation Division or its agents before plugging was commenced? Yes

Name of Conservation Agent who supervised plugging of this well Steve Durant  
Producing formation Morrow Depth to top 5596 Bottom 5632 Total Depth of Well 6294 Feet  
Show depth and thickness of all water, oil and gas formations. \$ 204.56

OIL, GAS OR WATER RECORDS

CASING RECORD

FORMATION	CONTENT	FROM	TO	SIZE	PUT IN	PULLED OUT
Toronto		4406		8-5/8"	1400'	None
Lansing		4536				
Morrow	Gas	5596	5632	2-7/8"	5772'	2600'

Describe in detail the manner in which the well was plugged, indicating where the mud fluid was placed and the method or methods used in introducing it into the hole. If cement or other plugs were used, state the character of same and depth placed, from feet to feet for each plug set.

Set C.I.B.P. @ 5561' w/ 1 Sx cement  
Shot off 2-7/8" Casing @ 2600'  
Set 35 Sx Cement Plug @ 2600'  
Set 40 Sx Cement Plug @ 1350' to 1450'  
Set 40 Sx Cement Plug @ 700'  
Set 10 Sx Cement Plug @ 40'  
Cut off 3' below ground level and weld on Plat

(If additional description is necessary, use BACK of this sheet)

Name of Plugging Contractor Sam's Well Service Halliburton set Cement Plugs  
Address P.O. Box 67, Guymon, Oklahoma 73942

STATE OF Texas, COUNTY OF Hansford, ss.  
Everett R. Tracy (employee of owner) or (owner or operator) of the above-described

well, being first duly sworn on oath, says: That I have knowledge of the facts, statements, and matters herein contained and the log of the above-described well as filed and that the same are true and correct. So help me God.

(Signature) *Everett R. Tracy*  
P.O. Box 7, Spearman, Texas 79081  
(Address)

SUBSCRIBED AND SWORN TO before me this 13 day of December 1983

*Notary Public*  
RECEIVED  
STATE CORPORATION COMMISSION

My commission expires 5/31/85

DEC 16 1983

CONSERVATION DIVISION  
Wichita, Kansas