

15-119-30088-0000


STATE OF KANSAS  
STATE CORPORATION COMMISSION

WELL PLUGGING RECORD

Give All Information Completely  
Make Required Affidavit  
Mryl or Deliver Report to:  
Conservation Division  
State Corporation Commission  
214 No. Broadway  
Wichita, Kansas

Meade County. Sec. 36 Twp. 32S Rge. 29W (E) (W)  
Location as "NE/CNW&SW&" or footage from lines C/SE/NW  
Lease Owner Horizon Oil & Gas Co. and Edwin L. Cox  
Lease Name Hallock "C" Well No. 1-36  
Office Address P.O. Box 7, Spearman, Texas 79081  
Character of Well (completed as Oil, Gas or Dry Hole) Dry Hole  
Date well completed June 28, 1966  
Application for plugging filed June 30 1966  
Application for plugging approved June 29 1966  
Plugging commenced June 29 1966  
Plugging completed June 30 1966  
Reason for abandonment of well or producing formation Dry Hole

NORTH

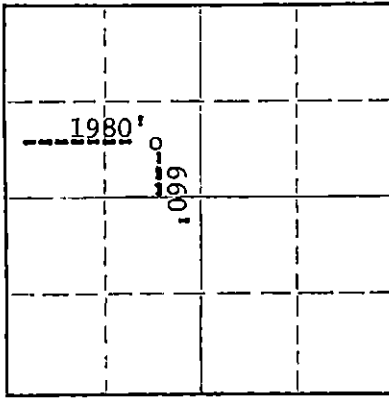

Locate well correctly on above  
Section Flat

If a producing well is abandoned, date of last production None 19      
Was permission obtained from the Conservation Division or its agents before plugging was commenced? Yes

Name of Conservation Agent who supervised plugging of this well Edgar J. Eves - Sublette, Kansas  
Producing formation none Depth to top - Bottom - Total Depth of Well 5825 Feet  
Show depth and thickness of all water, oil and gas formations.

OIL, GAS OR WATER RECORDS

CASING RECORD

FORMATION	CONTENT	FROM	TO	SIZE	PUT IN	PULLED OUT
	Water	3800	5800	8-5/8"	1435'	None

Describe in detail the manner in which the well was plugged, indicating where the mud fluid was placed and the method or methods used in introducing it into the hole. If cement or other plugs were used, state the character of same and depth placed, from - feet to - feet for each plug set.

Set 35 sx. cement plug @ 700' to 600'  
Set 15 sx. cement plug @ surface  
Welded on cap.

RECEIVED  
STATE CORPORATION COMMISSION  
7-1-66  
JUL 1 1966  
CONSERVATION DIVISION  
WICHITA, KANSAS

(If additional description is necessary, use BACK of this sheet)

Name of Plugging Contractor Moran Bros., Inc. and Halliburton  
Address Liberal, Kansas (for both)

STATE OF Hansford Texas, COUNTY OF Hansford, ss.  
Everett R. Tracy (employee of owner) or ~~known representative~~ of the above-described well, being first duly sworn on oath, says: That I have knowledge of the facts, statements, and matters herein contained and the log of the above-described well as filed and that the same are true and correct. So help me God.

(Signature)

Everett R. Tracy  
P.O. Box 7, Spearman, Texas 79081

(Address)

SUBSCRIBED AND SWORN to before me this 30th day of June, 1966

Jessie Faries

My commission expires June 1, 1966

Hansford County, Texas

Notary Public.

HORIZON OIL & GAS CO.  
 HALLOCK "C" NO. 1-36  
 MEADE COUNTY, KANSAS  
 Drillers Log

<u>FORMATION</u>	<u>TO</u>	<u>FROM</u>
Sand, redbed, shale	0	825
Redbed, shale, anhydrite	825	1435
Anhydrite	1435	1843
Redbed and anhydrite	1843	2375
Shale and anhydrite	2375	2627
Shale and anhydrite	2627	3190
Shale and chalky lime	3190	3390
Lime and shale	3390	3930
Lime and shale	3930	4631
Lime	4631	4797
Lime	4797	4850
Lime and shale	4850	4950
Lime	4950	5650
Lime and shale	5650	5825
<b>TOTAL DEPTH</b>		<b>5825</b>

CERTIFIED TRUE AND CORRECT.

MORAN BROS., INC.

By W.C. Hooper, Jr.  
 W. C. Hooper, Jr.

RECEIVED  
 JUL 15 1966  
 COMMISSIONER OF REVENUE  
 STATE OF KANSAS

RECEIVED  
 JUL 14 1966  
 HORIZON OIL AND GAS CO.  
 SPEARMAN, TEXAS