

Give All Information Completely
Make Required Affidavit
Mail or Deliver Report to:
Conservation Division
State Corporation Commission
211 No. Broadway
Wichita, Kansas

WELL PLUGGING RECORD

Meade County, Sec. 33 Twp. 32S Rge. 29 (E) (W)

Location as "NE/CNW/SW" or footage from lines S/2 S/2 - SE/4

Lease Owner J. M. Huber Corporation

Lease Name Seger Well No. 1

Office Address Box 978, Liberal, Kansas

Character of Well (completed as Oil, Gas or Dry Hole) Dry Hole

Date well completed 10-14 1964

Application for plugging filed 10-15 1964

Application for plugging approved 10-13 1964


Plugging commenced 10-14 1964

Plugging completed 10-14 1964

Reason for abandonment of well or producing formation Dry Hole

If a producing well is abandoned, date of last production _____ 19____

Was permission obtained from the Conservation Division or its agents before plugging was commenced? Yes

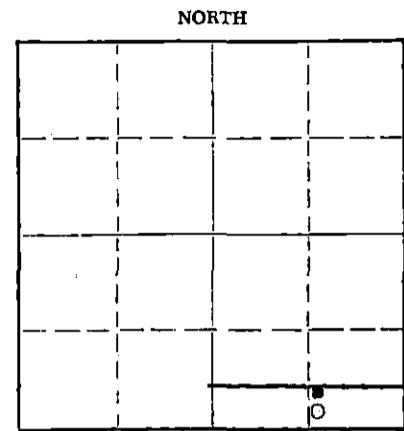

Locate well correctly on above Section Plat

Name of Conservation Agent who supervised plugging of this well Hugh E. Scott

Producing formation None Depth to top _____ Bottom _____ Total Depth of Well 5740 Feet

Show depth and thickness of all water, oil and gas formations.

OIL, GAS OR WATER RECORDS

CASING RECORD

FORMATION	CONTENT	FROM	TO	SIZE	PUT IN	PULLED OUT
None				8 5/8"	1558	0

Describe in detail the manner in which the well was plugged, indicating where the mud fluid was placed and the method or methods used in introducing it into the hole. If cement or other plugs were used, state the character of same and depth placed, from 700' feet to 600' feet for each plug set. & 45' to 0'.

Hole was filled with mud. With D.P. bottom @ 700' mixed 35 sacks of cement and displaced. Filled hole with mud to 45'. Dumped 15 sacks cement 45' to surface.

RECEIVED
STATE CORPORATION COMMISSION

OCT 16 1964

CONSERVATION DIVISION
Wichita, Kansas

(If additional description is necessary, use BACK of this sheet)

Name of Plugging Contractor Lohmann-Johnson Drilling Company

Address Evansville, Indiana

STATE OF Kansas, COUNTY OF Seward, ss. Harold Jones (employee of owner) or (owner/operator) of the above-described

well, being first duly sworn on oath, says: That I have knowledge of the facts, statements, and matters herein contained and the log of the above-described well, as filed and that the same are true and correct. So help me God.

(Signature) Harold Jones
Box 978, Liberal (Address)

SUBSCRIBED AND SWORN to before me this 15th day of October, 1964

My Commission Expires September 4, 1968

My commission expires _____

Pauline K. Wilson
Notary Public.

SEGER NO. 1
N. W. Borchers Field
330' FSL - 1320' FEL - Section 33-32S-29W
Meade County, Kansas

WELL RECORD

OPERATOR: J. M. HUBER CORPORATION
2401 East Second Avenue, Denver, Colorado
CONTRACTOR: LOHMANN-JOHNSON DRILLING CO., INC.
320 Indiana Bank Bldg., Evansville 8, Indiana
COMMENCED: September 29, 1964
COMPLETED: October 15, 1964
CASING: Ran 1558 ft. 8-5/8" Surface Casing set @ 1558 ft.
with 675 Sacks Cement
DRY & ABANDONED - Plugged 10/14/64.

FROM	TO	FORMATION
0	400	Sand
400	500	Gravel
500	850	Sand, Gravel & Gypsum
850	1286	Sand & Red Bed
1286	1559	Red Bed & Anhydrite
1559	2345	Red Bed & Shale
2345	2520	Shale & Lime
2520	2685	Lime
2685	2858	Lime & Shale
2858	3011	Lime
3011	3180	Shale & Lime
3180	3448	Shale, Lime & Chalk
3448	3675	Lime
3675	3803	Lime & Shale
3803	4080	Shale & Lime
4080	4640	Lime & Shale
4640	4680	Lime
4680	4810	Lime & Shale
4810	5005	Lime
5005	5165	Lime & Shale
5165	5220	Lime
5220	5505	Lime & Shale
5505	5686	Lime
5686	5733	Lime & Shale
5733	5740	Lime
5740		TOTAL DEPTH

RECEIVED
STATE CORPORATION COMMISSION
NOV 19 1964
CONSERVATION DIVISION
Wichita, Kansas

Dry & Abandoned - Plugged October 14, 1964

The undersigned, Lohmann-Johnson Drilling Co., Inc., hereby certifies that the above log is a true and correct log of the formations encountered in drilling the above well, as shown by the Daily Drilling Reports.

LOHMANN-JOHNSON DRILLING CO., INC.

By Joe Toehr
Joe Toehr, Asst. Secy

Subscribed and sworn to before me this 11th day of November, 1964

Helen Y. Shields
Notary Public

My Commission expires
November 5, 1965