


15-119-10216-0000

WELL PLUGGING RECORD

Give All Information Completely
Make Required Affidavit
Mail or Deliver Report to:
Conservation Division
State Corporation Commission
212 No. Market
Wichita, Kansas

Meade County, Sec. 31 Twp. 32 Rge. 29 (X) (W)

Location as "NE/CNW/SW" or footage from lines NE NE
Lease Owner Thomas & Brewer
Lease Name Angell Well No. 1
Office Address Box 1177, Liberal, Kansas
Character of Well (completed as Oil, Gas or Dry Hole) Oil
Date well completed 4-10 19 59
Application for plugging filed 1-30 19 67
Application for plugging approved 2-1 19 67
Plugging commenced 2-8 19 67
Plugging completed 2-10 19 67
Reason for abandonment of well or producing formation non commercial

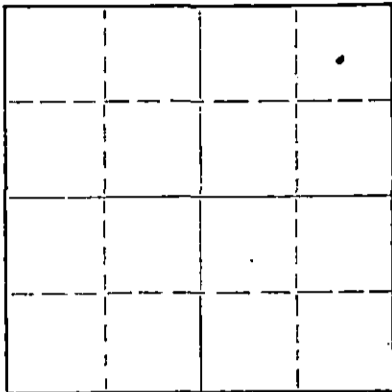

Locate well correctly on above Section Plat

If a producing well is abandoned, date of last production 12-20 19 66
Was permission obtained from the Conservation Division or its agents before plugging was commenced? Yes

Name of Conservation Agent who supervised plugging of this well Ed Eves
Producing formation Morrow Depth to top 5622 Bottom 5690 Total Depth of Well 5707 Feet
Show depth and thickness of all water, oil and gas formations.

OIL, GAS OR WATER RECORDS

CASING RECORD

FORMATION	CONTENT	FROM	TO	SIZE	PUT IN	PULLED OUT
Surface sand	Fresh water	60	490	8 5/8 5 1/2	1510 5740	None 2711

Describe in detail the manner in which the well was plugged, indicating where the mud fluid was placed and the method or methods used in introducing it into the hole. If cement or other plugs were used, state the character of same and depth placed, from _____ feet to _____ feet for each plug set.

Mix 20 sacks cement and one sack of hulls to plug off perforations. Stop plug at 5500 feet. Shoot pipe loose at 2711 feet and pull same. Make bridge at 700 feet and pump 40 sacks cement at 700 to 600 feet. Fill with mud to 35 feet and put 10 sacks cement at 35 feet to 0 feet. Cut off 8 5/8" and cap.

RECEIVED
STATE CORPORATION COMMISSION
FEB 28 1967
2-23-67
WICHITA, KANSAS

(If additional description is necessary, use BACK of this sheet)
Name of Plugging Contractor Sargents Casing Pulling Service
Address Box 506, Liberal, Kansas

STATE OF Kansas, COUNTY OF Seward, ss.
Delvin P. Luck (employee of owner) or (owner or operator) of the above-described

well, being first duly sworn on oath, says: That I have knowledge of the facts, statements, and matters herein contained and the log of the above-described well as filed and that the same are true and correct. So help me God.

(Signature) Delvin P. Luck
Box 1177, Liberal, Kansas
(Address)

SUBSCRIBED AND SWORN TO before me this 21 day of February, 19 67

My commission expires 11-5-70
Marlene Featung Notary Public.

Thomas & Brewer
Angell #1

CNE NE Sec. 31-32-29
Meade County, Kansas

R.T.D. 5770'

CONTRACTOR: Bennett & Roberts Drilling Co.

Commenced 2/14/59
Completed 3/15/59

Set 8 5/8" @ 1510' w/800 sx cmt.
Set 5 1/2" @ 5740' w/70 sx cmt.

Surface Soil & Clay	110'
Sand	490
Red Bed	515
Red Bed & Shells	920
Shale & Shells	1010
Sand & Shale	1090
Sand	1200
Shale	1235
Shale & Shells	1490
Anhydrite	1510
Shale	1570
Shale & Shells	2151
Shale & Lime	2334
Lime	2425
Shale	2520
Shale & Lime	2849
Lime	2876
Lime & Shale	2990
Lime	3050
Lime & Shale	3219
Lime	3330
Lime & Chalk stringers	3393
Lime & Chalk	3543
Chalky Lime	3565
Lime & Chalky Lime	3671
Lime & Chalk	3780
Lime, Chalky Lime & Shale	3833
Lime & Shale	4140
Lime & Shale Streaks	4172
Lime & Shale	4440
Lime	4634
Cherty Lime	4675
Lime	4966
Lime & Shale Streaks	5010
Lime	5082
Lime & Shale	5127
Lime	5592
Lime & Shale	5770

RECEIVED
STATE CORPORATION COMMISSION
FEB 28 1959
CONSERVATION DIVISION
Topeka, Kansas

STATE OF KANSAS)
RUSSELL COUNTY) SS.

I hereby certify that the above information is true and correct to the best of my knowledge.

BENNETT & ROBERTS DRILLING CO.

By *Harold W. Bennett*

Subscribed and sworn to before this 19th day of March, 1959.

Clara Hummel
Notary Public

My Commission expires 6/17/62