


Give All Information Completely
Make Required Affidavit
Mail or Deliver Report to:
Conservation Division
State Corporation Commission
211 No. Broadway
Wichita, Kansas

WELL PLUGGING RECORD

Meade County, Sec. 29 Twp. 32 Rge. (E) 29 (W) SW/4 SW/4

Location as "NE/CNW/SW" or footage from lines.
Lease Owner Thomas & Brewer
Lease Name Angell Well No. A-1
Office Address Drawer 1177 Liberal, Kansas
Character of Well (completed as Oil, Gas or Dry Hole) Gas
Date well completed 4-3-61
Application for plugging filed 11 - 17 19 65
Application for plugging approved 11 - 19 19 65
Plugging commenced 11 - 19 19 65
Plugging completed 11 - 20 19 65
Reason for abandonment of well or producing formation Depleted

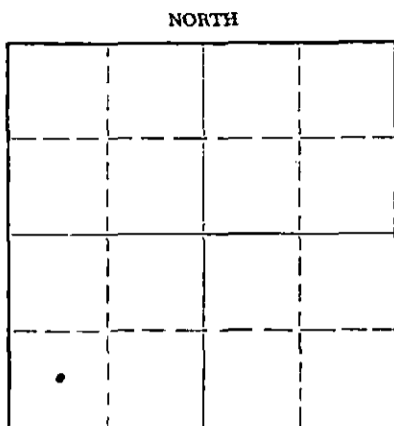

Locate well correctly on above Section Plat

If a producing well is abandoned, date of last production 10-22 19 65
Was permission obtained from the Conservation Division or its agents before plugging was commenced? Yes

Name of Conservation Agent who supervised plugging of this well Hugh Scott
Producing formation Morrow Depth to top 5586 Bottom 5694 Total Depth of Well 5780 Feet
Show depth and thickness of all water, oil and gas formations.

OIL, GAS OR WATER RECORDS

CASING RECORD

FORMATION	CONTENT	FROM	TO	SIZE	PUT IN	PULLED OUT
				8 5/8	1480	0
				4 1/2	5770	1693

Describe in detail the manner in which the well was plugged, indicating where the mud fluid was placed and the method or methods used in introducing it into the hole. If cement or other plugs were used, state the character of same and depth placed, from _____ feet to _____ feet for each plug set.

To plug off perforations Mix 20 sacks cement and stop plug at 5400 feet. Shoot pipe loose at 1693 feet and lay down to 700 feet. Pump 35 sacks cement at 700 feet to 600 feet. Finish laying down 4 1/2" casing and put 15 sacks cement at 45 feet to 0 feet. Cut off 8 5/8" casing 3 feet below ground level and weld cap on same.

RECEIVED
STATE CORPORATION COMMISSION

12-14-65
DEC 14 1965

CONSERVATION DIVISION
Wichita, Kansas

Name of Plugging Contractor Sargent's Casing Pulling Service
Address Box 506 Liberal, Kansas

STATE OF KANSAS, COUNTY OF SEWARD, ss. Delvin P. Luck (employee of owner) or (owner) of the above-described well, being first duly sworn on oath, says: That I have knowledge of the facts, statements, and matters herein contained and the log of the above-described well as filed and that the same are true and correct. So help me God.

(Signature) Delvin P. Luck
Drawer 1177, Liberal, Kansas
(Address)

SUBSCRIBED AND SWORN to before me this 13 day of December, 19 65

My commission expires HILA J. BREWER
NOTARY PUBLIC, SEWARD COUNTY, KANS.
MY COMMISSION EXPIRES APRIL 8, 1968

Lila J. Brewer
Notary Public.

THOMAS & BREWER
ANGELL A#1

SW SW of Section 29-32S-29W
Meade County, Kansas

RTD: 5780

8 5/8 @ 1481 w/650 sx cement
4 1/2 @ 5750 w/100 sx cement

Commenced 11/7/60
Completed 11/28/60

CONTRACTOR: Bennett & Roberts Drilling Co.

Surface Soil & Clay	160
Sand	440
Shale & Shells	650
Red Bed	998
Shale & Shells	1085
Sand	1215
Shale & Shells	1465
Anhydrite	1496
Shale & Shells	2195
Shale & Lime	2475
Lime	2766
Lime & Shale	2856
Lime	3063
Lime & Chalk Stringers	3200
Lime & Chalk Streaks	3320
Lime	3400
Lime & Chalk	3680
Lime	3781
Shale & Lime	4020
Lime	4210
Lime & Shale	4510
Lime	4630
Lime & Shale	4680
Lime	5739
Lime & Shale	5780

RECEIVED
STATE CORPORATION COMMISSION
JAN 21 1966
CONSERVATION DIVISION
Wichita, Kansas

STATE OF KANSAS)
RUSSELL COUNTY) SS.

I hereby certify that the above information is correct to the best of my knowledge.

BENNETT & ROBERTS DRILLING CO.

By Maedred Belbrey

Subscribed and sworn to before me this 2nd day of December, 1960.

Charles Thomas
Notary Public

My Commission Expires 6/17/62