


STATE OF KANSAS
STATE CORPORATION COMMISSION

WELL PLUGGING RECORD

Give All Information Completely
Make Required Affidavit
Mail or Deliver Report to:
Conservation Division
State Corporation Commission
800 Bifling Building
Wichita, Kansas

Meade County. Sec. 27 Twp. 32 Rge. 29 XEX (W)
Location as "NE/CNW 1/4 SW 1/4" or footage from lines SW 1/4, SW 1/4, NE 1/4
Lease Owner Champlin Refining Company
Lease Name Rickers #1 Well No. 1
Office Address Drawer 552, Enid, Oklahoma
Character of Well (completed as Oil, Gas or Dry Hole) Dry Hole
Date well completed October 21 19 52
Application for plugging filed October 27 19 52
Application for plugging approved 19
Plugging commenced November 12 19 52
Plugging completed November 17 19 52
Reason for abandonment of well or producing formation Dry Hole
If a producing well is abandoned, date of last production 19
Was permission obtained from the Conservation Division or its agents before plugging was commenced? Yes

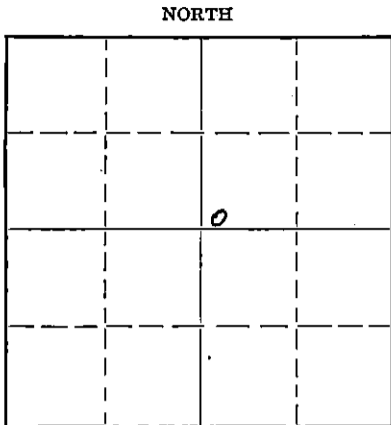

Locate well correctly on above Section Plat

Name of Conservation Agent who supervised plugging of this well M. A. Rives, Box 148, Pratt, Kansas
Producing formation See below Depth to top Bottom Total Depth of Well 5850 Feet
Show depth and thickness of all water, oil and gas formations.

OIL, GAS OR WATER RECORDS

CASING RECORD

Formation	Content	From	To	Size	Put In	Pulled Out
Chester	Show gas	5740	5767	653	13 3/8"	None
Marrow	" "	5636	5646	2802	9 5/8"	"
Cherokee	No Show	5545	5555	5 1/2" OD	5850	2490
Marmaton	Show gas	5481	5342			
Marmaton	Oil & water	5248	5342			
Lansing	Water	4922	4997			
Lansing	"	4737	4745			

Describe in detail the manner in which the well was plugged, indicating where the mud fluid was placed and the method or methods used in introducing it into the hole. If cement or other plugs were used, state the character of same and depth placed, from.....feet to.....feet for each plug set.

Perf. 5740-67. Set Baker bridge plug at 5668. Perf. 5636-46. Set Baker bridge plug at 5570. Perf. 5545-55. Set Baker bridge plug at 5500. Perf. 5481-76. Set Baker bridge plug at 5370. Perf. 5306-42. Squeezed with 250 sacks cement. Perf. 5276-80. Squeezed with 250 sacks cement. Perf. 5248-64. Squeezed with 50 gals. plastic. Perf. 4957-97. Squeezed with 250 sacks cement. Perf. 4922-32. Squeezed with 50 gals. Plastic. Perf. 4936-46. Set plug at 4760. Perf. 4737-45. Plugged back 4760-4725 with crushed rock and dumped 5 sacks cement with dump bailer top cement 4690. Filled hole with mud 4690-2350 set rock bridge at 2350 and dumped 10 sacks cement in 9 5/8" casing with dump bailer. Top of cement 2300. Welded steel plate over top of 9 5/8" casing.

NOTE:

This well originally drilled to 7637 and plugged by Stanolind Oil And Gas Company. the 13 3/8" and 9 5/8" casing in hole belongs to Stanolind Oil And Gas Company.

(If additional description is necessary, use BACK of this sheet)

Correspondence regarding this well should be addressed to Champlin Refining Company
Address Production Department, Drawer 552, Enid, Oklahoma

NOV 29 1952 11-29-52
CONSERVATION DIVISION
WICHITA, KANSAS

STATE OF Kansas, COUNTY OF Finney, ss.
J. E. Hodges (employee of owner) or (owner or operator) of the above-described well,
being first duly sworn on oath, says: That I have knowledge of the facts, statements, and matters herein contained and the log of the above-described well as filed and that the same are true and correct. So help me God.

(Signature) J. E. Hodges
401 1/2 North main Garden City (Address)

SUBSCRIBED AND SWORN to before me this 25 day of November, 19 52

Notary Public. H. M. Stowell

My commission expires Aug-10-1954

PLUGGING
FILE SEC 227-32R-292
BOOK PAGE 56 LINE 1