

STATE OF KANSAS
STATE CORPORATION COMMISSION


WELL PLUGGING RECORD

Give All Information Completely
Make Required Affidavit
Mail or Deliver Report to:
Conservation Division
State Corporation Commission
211 No. Broadway
Wichita, Kansas

Meade County, Sec. 18 Twp. 32S Rge. 30 (E) (W)

Location as "NE/CNW%SW%" or footage from lines NE SE
Lease Owner Thomas & Brewer
Lease Name Langhofer Well No. 1
Office Address Box 985 - Liberal, Kansas
Character of Well (completed as Oil, Gas or Dry Hole) Dry
Date well completed 9-28-59 19 59
Application for plugging filed 9-28 19 59
Application for plugging approved 9-28 19 59
Plugging commenced 9-29 19 59
Plugging completed same 19
Reason for abandonment of well or producing formation Non Productive

NORTH

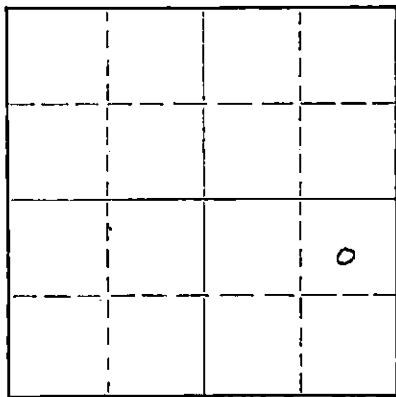

Locate well correctly on above Section Flat

If a producing well is abandoned, date of last production _____ 19____
Was permission obtained from the Conservation Division or its agents before plugging was commenced? yes

Name of Conservation Agent who supervised plugging of this well M.A. Rives
Producing formation _____ Depth to top _____ Bottom _____ Total Depth of Well _____ Feet
Show depth and thickness of all water, oil and gas formations.

OIL, GAS OR WATER RECORDS

CASING RECORD

FORMATION	CONTENT	FROM	TO	SIZE	PUT IN	PULLED OUT

Describe in detail the manner in which the well was plugged, indicating where the mud fluid was placed and the method or methods used in introducing it into the hole. If cement or other plugs were used, state the character of same and depth placed, from _____ feet to 50 feet for each plug set.

Bridge Plug @ 600' w/20 sacks cement. Fill up with heavy mud to 50'; #2 plug @ 50' with 1/4 sack hulls, 10 sx. cement

RECEIVED
STATE CORPORATION COMMISSION
FEB 4 1960
2-4-60
CONSERVATION DIVISION
Wichita, Kansas

(If additional description is necessary, use BACK of this sheet)
Name of Plugging Contractor Bennett & Roberts
Address Russell, Kansas

STATE OF Kansas, COUNTY OF Seward, ss.
George W. Brewer, Jr. (employee of owner) or (owner or operator) of the above-described well, being first duly sworn on oath, says: That I have knowledge of the facts, statements, and matters herein contained and the log of the above-described well as filed and that the same are true and correct. So help me God.

(Signature) George W. Brewer, Jr.
(Address) _____

SUBSCRIBED AND SWORN TO before me this 3rd day of February, 1960
My commission expires November 5, 1962
Marlene Keating
Notary Public.



THOMAS & BREWER
LANGHOFER #1

C/NE SE Sec. 18-32-30
Meade County, Kansas

RTD 5710'

CONTRACTOR: Bennett & Roberts Drilling Co.

Commenced 9/4/59
Completed 9/28/59

8 5/8" Set @ 1618' w/700 sx cmt.

Shale & Clay	100
Sand	400
Shale & Red Bed	1095
Red Bed, Lime Streaks	1600
Anhydrite	1635
Shale & Lime Streaks	1688
Shale	1878
Shale & Shells	2383
Shale & Lime	2955
Lime	3100
Lime & Shale	3175
Chalky Lime & Shale	3320
Lime	3415
Chalky Lime	3492
Chalky Lime & Shale	3615
Chalky Lime	3780
Lime & Shale	3915
Chalky Lime	4040
Lime & Shale	4194
Lime	4220
Lime & Shale	4575
Lime	4627
Lime & Shale	5140
Lime	5710

RECEIVED
STATE CORPORATE COMMISSION

FEB 4 1960

CONSERVATION DIVISION
Wichita, Kansas

STATE OF KANSAS)
RUSSELL COUNTY)

I hereby certify that the above information is correct to the best of my knowledge.

BENNETT & ROBERTS DRILLING CO.

By John R. Gurnea

Subscribed and sworn to before me this 30th day of September, 1959.

Clara Hummel
Notary Public

My Commission Expires 6/17/62