

15-175-00124-0001


STATE OF KANSAS
STATE CORPORATION COMMISSION

Give All Information Completely
Make Required Affidavit
Mail or Deliver Report to
Conservation Division
State Corporation Commission
245 North Water
Wichita, KS 67202

FORM CP-4

WELL PLUGGING RECORD

Seward County, Sec. 25 Twp. 32S Rge. 31 (E) (W) X
Location as "NE/CNWKSW" or footage from lines C NE SW
Lease Owner Ray Tam Ind., Inc.
Lease Name Richardson Well No. 1
Office Address Box 1578 Liberal, Kansas 67901
Character of Well (completed as Oil, Gas or Dry Hole)
Date well completed 19__
Application for plugging filed 7-20- 19 77
Application for plugging approved 7-20 19 77
Plugging commenced 7-21 19 77
Plugging completed 7-22 19 77
Reason for abandonment of well or producing formation

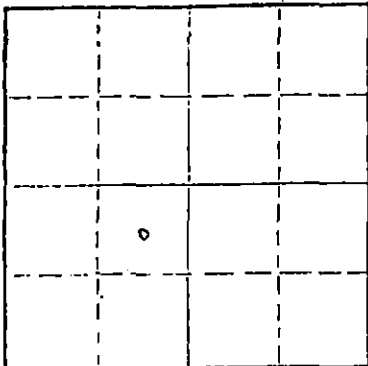

Locate well correctly on above Section Plot

If a producing well is abandoned, date of last production 19__
Was permission obtained from the Conservation Division or its agents before plugging was commenced? Yes

Name of Conservation Agent who supervised plugging of this well Clarence Thomas
Producing formation Depth to top Bottom Total Depth of Well 5846
Show depth and thickness of all water, oil and gas formations.

OIL, GAS OR WATER RECORDS

CASING RECORD


FORMATION	CONTENT	FROM	TO	SIZE	PUT IN	PULLED OUT
				8 5/8	1269	none
				4 1/2	5844	2605

Describe in detail the manner in which the well was plugged, indicating where the mud fluid was placed and the method or methods used in introducing it into the hole. If cement or other plugs were used, state the character of same and depth placed, from feet to feet for each plug set.

Pump 20 sks. of cement displace 5 bbls. fluid Pump 20 sks. of cement displace to 5100 ft. Pump 35 sks. of cement to 1200 ft.
Put 15 sks. of cement from 110 to 0

(If additional description is necessary, use BACK of this sheet)
Name of Plugging Contractor Sargents Casing Pulling Service Kansas No. 511
Address Box 506 Liberal, Kansas 67901

STATE OF Kansas COUNTY OF Seward ss.
Ned E. Lowry, Agent (employee of owner) or (owner or operator) of the above-described well, being first duly sworn on oath, says: That I have knowledge of the facts, statements, and matters herein contained and the log of the above-described well as filed and that the same are true and correct. So help me God.

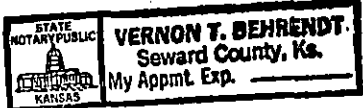

(Signature) Ned E. Lowry

Lowry's Lease Management, Inc., Box 1578
Liberal, Kansas 67901

SUBSCRIBED AND SWORN to before me this 28th day of July 19 77
My commission expires 12/31/79
Vernon T. Behrendt Notary Public.

RECEIVED
STATE CORPORATION COMMISSION

JUL 29 1977

CONSERVATION DIVISION
Wichita, Kansas

15-175-00124-0001

Richardson No. 1
C-NE-SW Sec. 25-32S-31W
Seward County, Kansas
Company: Rip C. Underwood

Well Commenced 3/10/63
8-5/8" casing set @ 1269'
circulated w/ cement (650 sks).
Plugged 3/30/63

FORMATION LOG

Sand & shale	0-590
Shale & shells	590-940
Red Bed & sand	940-1270
Red Bed & Shells	1270-1680
Red Bed & Anhydrite	1680-2110
Shale & Anhydrite	2110-2154
Shale & Shells	2154-2480
Shale & Lime	2480-2610
Lime	2610-3190
Lime & Shale	3190-3795
Lime	3795-4120
Lime & Shale	4120-4240
Lime	4240-4455
Cherty Lime	4455-4515
Lime	4515-5552
Lime & Shale	5552-5612
Lime	5612-6090
T.D.	6090

RECEIVED

STATE CORPORATION COMMISSION

APR 2 1963

CONSERVATION DIVISION

Wichita, Kansas

This is a true and exact copy of the formation, taken from The Daily Drilling Reports.

MAHONEY DRILLING COMPANY, INC.

T. W. Mahoney
T. W. Mahoney, President

STATE OF KANSAS
COUNTY OF SEWARD

Sworn to before me this 31st Day of March, 1963.

My Commission Expires:

Marie Staley
Notary Public

RECEIVED
STATE CORPORATION COMMISSION
JUL 22 1977
CONSERVATION DIVISION
Wichita, Kansas