

Give All Information Completely  
Make Required Affidavit  
Mail or Deliver Report to:  
Conservation Division  
State Corporation Commission  
211 No. Broadway  
Wichita, Kansas

WELL PLUGGING RECORD

Seward County. Sec. 25 Twp. 32 Rge. (E) 31(W)

Location as "NE/CNW%SW%" or footage from lines C-NE-SW

Lease Owner Rip C. Underwood

Lease Name Richardson

Well No. 1

Office Address 553 First Nat'l. Bank Bldg., Amarillo, Texas

Character of Well (completed as Oil, Gas or Dry Hole) Dry Hole

Date well completed March 30 1963

Application for plugging filed March 30 1963

Application for plugging approved March 30 1963


Plugging commenced March 30 1963

Plugging completed March 30 1963

Reason for abandonment of well or producing formation Dry Hole.

If a producing well is abandoned, date of last production \_\_\_\_\_ 19\_\_\_\_

Was permission obtained from the Conservation Division or its agents before plugging was commenced? Yes

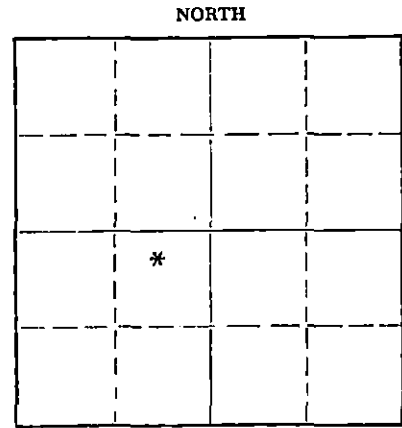

Locate well correctly on above Section Plat

Name of Conservation Agent who supervised plugging of this well Hugh Scott

Producing formation \_\_\_\_\_ Depth to top \_\_\_\_\_ Bottom \_\_\_\_\_ Total Depth of Well 6090 Feet

Show depth and thickness of all water, oil and gas formations.

OIL, GAS OR WATER RECORDS

CASING RECORD

FORMATION	CONTENT	FROM	TO	SIZE	PUT IN	PULLED OUT
Sand	Water			8-5/8	1269'	None

Describe in detail the manner in which the well was plugged, indicating where the mud fluid was placed and the method or methods used in introducing it into the hole. If cement or other plugs were used, state the character of same and depth placed, from \_\_\_\_\_ feet to \_\_\_\_\_ feet for each plug set.

Mudded hole from 6090' to 1265' set 35 sack cement. Plug from 1265' to 1142' mudded up to 613' set 15 sack plug from 613' up to 560' mudded up to 40'. Dumped 15 sack from 40' to top of hole.

RECEIVED  
STATE CORPORATION COMMISSION

APR 2 1963

CONSERVATION DIVISION  
Wichita, Kansas

(If additional description is necessary, use BACK of this sheet)

Name of Plugging Contractor Mahoney Drilling Company, Inc.

Address P. O. Box #1257, Liberal, Kansas

STATE OF Texas COUNTY OF Potter, ss.  
H. D. Thompson (employee of owner) or (owner or operator) of the above-described

well, being first duly sworn on oath, says: That I have knowledge of the facts, statements, and matters herein contained and the log of the above-described well as filed and that the same are true and correct. So help me God.

(Signature)

553 First Nat. Bank, Bldg. (P.O. Box 2588), Amarillo, Texas  
(Address)

SUBSCRIBED AND SWORN TO before me this 1st day of April, 1963

Notary Public.

My commission expires June 1st, 1963



Richardson No. 1  
C-NE-SW Sec. 25-32S-31W  
Seward County, Kansas  
Company: Rip C. Underwood

Well Commenced 3/10/63  
8-5/8" casing set @ 1269'  
circulated w/ cement (650 sks).  
Plugged 3/30/63

FORMATION LOG

Sand & shale	0-590
Shale & shells	590-940
Red Bed & sand	940-1270
Red Bed & Shells	1270-1680
Red Bed & Anhydrite	1680-2110
Shale & Anhydrite	2110-2154
Shale & Shells	2154-2480
Shale & Lime	2480-2610
Lime	2610-3190
Lime & Shale	3190-3795
Lime	3795-4120
Lime & Shale	4120-4240
Lime	4240-4455
Cherty Lime	4455-4515
Lime	4515-5552
Lime & Shale	5552-5612
Lime	5612-6090
T.D.	6090

**RECEIVED**  
STATE CORPORATION COMMISSION  
APR 2 1963  
CONSERVATION DIVISION  
Wichita, Kansas

This is a true and exact copy of the formation, taken from The Daily Drilling Reports.

MAHONEY DRILLING COMPANY, INC.

T. W. Mahoney  
T. W. Mahoney, President

STATE OF KANSAS  
COUNTY OF SEWARD

Sworn to before me this 3<sup>rd</sup> Day of March, 1963.

My Commission Expires:

Mavis Staley  
Notary Public