


STATE OF KANSAS
STATE CORPORATION COMMISSION

See All Information Completely
Make Required Affidavit
Mail or Deliver Report to:
Conservation Division
State Corporation Commission
212 North Market, Insurance Bldg.
Wichita, Kansas

WELL PLUGGING RECORD

Seward County, Sec. 23 Twp. 32S Rge. (E) 31 (W)

Location as "NE/CNW/SW" or footage from lines
Lease Owner Yucca Petroleum Co.
Lease Name Krause Well No. 1
Office Address P.O. Box 2585, Amarillo, Texas 79105
Character of Well (completed as Oil, Gas or Dry Hole) Gas
Date well completed March 6 19 70
Application for plugging filed December 6 19 73
Application for plugging approved December 10 19 73
Plugging commenced February 26 19 74
Plugging completed February 27 19 74
Reason for abandonment of well or producing formation Well uneconomical to produce

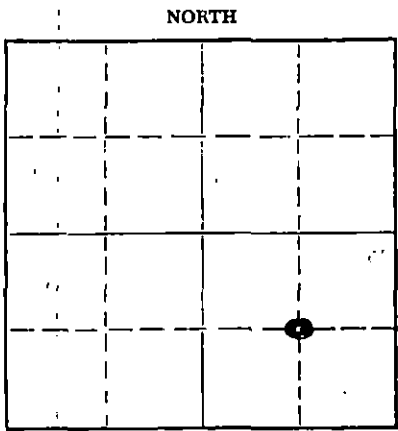

Locate well correctly on above Section Plat

If a producing well is abandoned, date of last production October 19 73
Was permission obtained from the Conservation Division or its agents before plugging was commenced? Yes

Name of Conservation Agent who supervised plugging of this well Mr. Edgar Eves
Producing formation Lansing Depth to top 4404 Bottom 4412 Total Depth of Well 6068 Feet
Show depth and thickness of all water, oil and gas formations.

OIL, GAS OR WATER RECORDS

CASING RECORD

FORMATION	CONTENT	FROM	TO	SIZE	PUT IN	PULLED OUT
Lansing		4406	4411	8 5/8" OD	1660'	0
				4 1/2" OD	6067'	2247'

Describe in detail the manner in which the well was plugged, indicating where the mud fluid was placed and the method or methods used in introducing it into the hole. If cement or other plugs were used, state the character of same and depth placed, from _____ feet to _____ feet for each plug set.

Well plugged by Daco Lease & Well Service under the supervision of a Corporation Commission of Kansas representative. Plugs as follows:

- 25 sk. cmt. plug from 2950' to 3082', cement displaced with 9.5# mud down 4 1/2" csg.
- 35 sk. cmt. plug spotted across base of 8 5/8" csg. while pulling 4 1/2" csg. this plug from 899' to 1000', plug spotted using 9.5# mud.
- 15 sk. cmt. plug spotted from 50' to surface while pulling 4 1/2" csg., used 9.5# mud to spot plug.

All mud used--9.5#/gal. and 38 Vis.

RECEIVED
STATE CORPORATION COMMISSION
MAR 20 1974
CONSERVATION DIVISION
Wichita, Kansas

(If additional description is necessary, use BACK of this sheet)
Name of Plugging Contractor Daco Lease & Well Service
Address 1700 South Main, Borger, Texas 79007

STATE OF Texas, COUNTY OF Potter, ss.
I, T. P. Northern (employee of owner) or (owner or operator) of the above-described well, being first duly sworn on oath, says: That I have knowledge of the facts, statements, and matters herein contained and the log of the above-described well as filed and that the same are true and correct. So help me God.

(Signature) T. P. Northern
P. O. Box 2585, Amarillo, Texas 79105
(Address) 74

SUBSCRIBED AND SWORN TO before me this 11th day of March, 19 74

My commission expires 5-1-75
Patti Leach, Notary Public in and for Potter County, Texas

Yucca Petroleum Company
Amarillo, Texas

Drig. Contractor: Stickle Drilling Company
Date Commenced: 19 January 1970
Date Completed: 5 February 1970

Krause No. 1
SE SE 23-32S-31W
Seward County, Kansas

DRILLER'S LOG

Depth figures indicate base of formation:

Surface Soil and Clay	70
Sand and Clay	425
Red Bed	1075
Red Bed and Anhydrite	1491
Red Bed and Shale	1591
Anhydrite and Red Bed	1718
Red Bed	1945
Red Bed and Anhydrite	2350
Anhydrite and Shale	2530
Lime and Anhydrite	2675
Anhydrite and Dolomite	2920
Lime and Shale	3091
Lime	5320
Shale and Lime	5412
Lime and Shale	5487
Lime and Sand	5539
Lime and Shale	5663
Lime and Sand	5705
Lime and Shale	5724
Lime	6065 RTD

RECEIVED
STATE CORPORATION COMMISSION
DEC 10 1973
CONSERVATION DIVISION
Wichita, Kansas

I, Clifford M. Smith, hereby certify that to the best of my knowledge and belief, the above is a true and complete Driller's Log of Yucca Petroleum Company's Krause No. 1 in Seward County, Kansas.

Clifford M. Smith
Clifford M. Smith

Freida E. Widick
Freida E. Widick, Notary Public
My Commission Expires 23 June 1970
NOTARY
FREIDA E. WIDICK
BUTLER COUNTY, KANSAS