


WELL PLUGGING RECORD

Give All Information Completely
Make Required Affidavit
Mail or Deliver Report to:
Conservation Division
State Corporation Commission
212 No. Market
Wichita, Kansas

Seward County, Sec. 23 Twp. 32S. Rge. (E) 31 (W)

NORTH

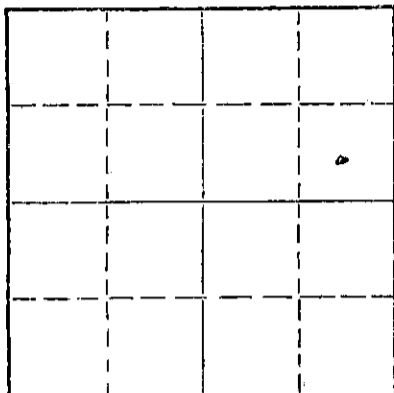

Locate well correctly on above
Section Plat

Location as "NE/CNW/SW" or footage from lines
Lease Owner First National Oil Inc.
Lease Name Fieser Well No. 1
Office Address 23 E 11th Park Plaza, Liberal, Kansas 67901
Character of Well (completed as Oil, Gas or Dry Hole) D&A
Date well completed 1-4-75 19
Application for plugging filed 19
Application for plugging approved 19
Plugging commenced 1-5-75 19
Plugging completed 1-5-75 19
Reason for abandonment of well or producing formation Dry

If a producing well is abandoned, date of last production 19
Was permission obtained from the Conservation Division or its agents before plugging was commenced? Yes

Name of Conservation Agent who supervised plugging of this well G. Thomas
Producing formation _____ Depth to top _____ Bottom _____ Total Depth of Well 3207 Feet
Show depth and thickness of all water, oil and gas formations.

OIL, GAS OR WATER RECORDS

CASING RECORD

FORMATION	CONTENT	FROM	TO	SIZE	PUT IN	PULLED OUT
Herington		3160		8-5/8	619'	
U. Krider		3183				

Describe in detail the manner in which the well was plugged, indicating where the mud fluid was placed and the method or methods used in introducing it into the hole. If cement or other plugs were used, state the character of same and depth placed, from _____ feet to _____ feet for each plug set.

Hole was filled with heavy drilling mud through drill pipe. Cement plugs were pumped through drill pipe by Howco - 60 sks 900' to 700'; 35 sks 500' to 400'; 15 sks 45' to 0'

RECEIVED
STATE CORPORATION COMMISSION
MAY 19 1975
CONSERVATION DIVISION
Wichita, Kansas

(If additional description is necessary, use BACK of this sheet)

Name of Plugging Contractor Dotson Drilling Co.
Address 5101 N. Pennsylvania, Oklahoma City, OK 73112

STATE OF OKLAHOMA, COUNTY OF LINCOLN, ss.
T. W. Paek (employee of owner) or (owner or operator) of the above-described well, being first duly sworn on oath, says: That I have knowledge of the facts, statements, and matters herein contained and the log of the above-described well as filed and that the same are true and correct. So help me God.

(Signature) T. W. Paek
305 W 3rd St., Stroud, OK 74079
(Address)

SUBSCRIBED AND SWORN TO before me this 14th day of May, 1975

My commission expires June 15, 1978

Margaret Mae Ailey
Notary Public.