


15-175-20115-0000-4

STATE OF KANSAS
STATE CORPORATION COMMISSION

WELL PLUGGING RECORD

Give All Information Completely
Make Required Affidavit
Mail or Deliver Report to:
Conservation Division
State Corporation Commission
212 North Market, Insurance Bldg.
Wichita, Kansas

Seward County, Sec. 22 Twp. 32S Rge. 31 (E) (W)

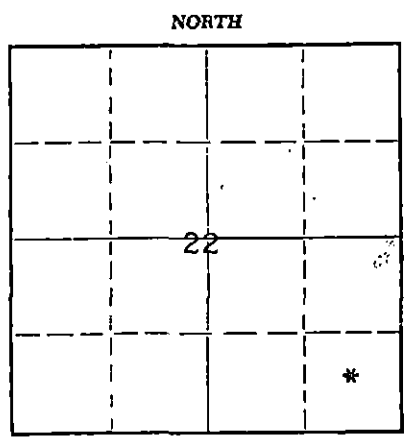

Location as "NE/CNWKSWK" or footage from lines C SE SE
Lease Owner Yucca Petroleum Co.
Lease Name Espana Well No. 1
Office Address P. O. Box 2585, Amarillo, Texas 79105
Character of Well (completed as Oil, Gas or Dry Hole) Gas
Date well completed September 8 19 70
Application for plugging filed January 12 19 71
Application for plugging approved January 12 19 71
Plugging commenced January 14 19 71
Plugging completed January 18 19 71
Reason for abandonment of well or producing formation Not economical to operate
If a producing well is abandoned, date of last production None 19
Was permission obtained from the Conservation Division or its agents before plugging was commenced? Yes

Name of Conservation Agent who supervised plugging of this well Edgar Eves
Producing formation Kansas City Depth to top Bottom Total Depth of Well 6090 Feet
Show depth and thickness of all water, oil and gas formations.

OIL, GAS OR WATER RECORDS

CASING RECORD

FORMATION	CONTENT	FROM	TO	SIZE	PUT IN	PULLED OUT
		0	1632'	8-5/8"	39 jts.	

Describe in detail the manner in which the well was plugged, indicating where the mud fluid was placed and the method or methods used in introducing it into the hole. If cement or other plugs were used, state the character of same and depth placed, from 0' feet to 4415 feet for each plug set.

0' - 40' 10 sks. cement
900' - 1000' 35 sks. cement
4000' - 4415' 10 sks. cement

RECEIVED
STATE CORPORATION COMMISSION
JAN 27 1971
CONSERVATION DIVISION
Wichita, Kansas

(If additional description is necessary, use BACK of this sheet)
Name of Plugging Contractor Sargent's Service
Address Liberal, Kansas

STATE OF TEXAS, COUNTY OF POTTER, ss.
E. C. Podzemny (employee of owner) or ~~owner~~ of the above-described well, being first duly sworn on oath, says: That I have knowledge of the facts, statements, and matters herein contained and the log of the above-described well as filed and that the same are true and correct. So help me God.

(Signature) E. C. Podzemny
P. O. Box 2585, Amarillo, Texas 79105
(Address)

SUBSCRIBED AND SWORN TO before me this 25th day of January, 19 71

Karen Sue Becken
Notary Public.

My commission expires 6-1-71

Yucca Petroleum Company
Amarillo, Texas 79101

Drig. Contractor: Stickle Drilling Company
Date Commenced: 10 August 1970
Date Completed: 27 August 1970

Espana No. 1
C SE SE 22-32S-31W
Seward County, Kansas


DRILLER'S LOG

Depth figures indicate base of formation:

Sand	520
Clay and Red Bed	630
Red Bed	1632
Red Bed and Anhydrite	2500
Lime and Shale	2627
Lime	2840
Dolomite	3070
Lime	3797
Lime and Shale	4150
Lime	4175
Lime and Shale	4330
Lime	6090 RTD

I, R. B. Parriott, hereby certify that to the best of my knowledge and belief, the above is a true and complete Driller's Log of Yucca Petroleum Company's Espana No. 1 in Seward County, Kansas.

R. B. Parriott
R. B. Parriott

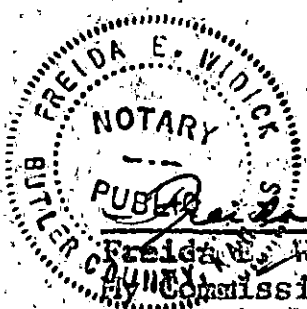

Freida E. Widick
Freida E. Widick, Notary Public
My Commission Expires 23 June 1974