


WELL PLUGGING RECORD

Give All Information Completely  
Make Required Affidavit  
Mail or Deliver Report to:  
Conservation Division  
State Corporation Commission  
211 No. Broadway  
Wichita, Kansas

SEWARD County, Sec. 1 Twp. 32s Rge. 32W (X) X (W)

Location as "NE/CNWxSWx" or footage from lines C SW NE  
Lease Owner PETROLEUM, INC.,  
Lease Name DOLVEN UNIT Well No. 2  
Office Address ROUTE 2, GREAT BEND, KANSAS  
Character of Well (completed as Oil, Gas or Dry Hole) DRY  
Date well completed FEBRUARY 1, 1963  
Application for plugging filed MAY 16, 1963  
Application for plugging approved MAY 17, 1963  
Plugging commenced MAY 25, 1963  
Plugging completed MAY 25, 1963  
Reason for abandonment of well or producing formation NO PRODUCIBLE FORMATIONS

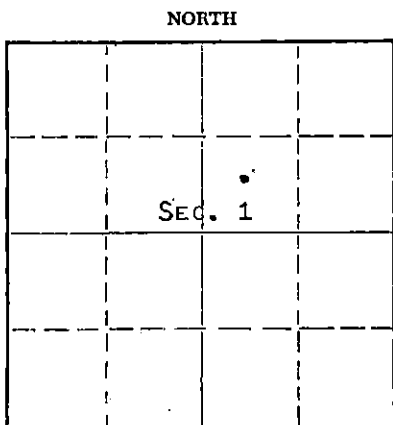

Locate well correctly on above  
Section Plat

If a producing well is abandoned, date of last production NONE 19  
Was permission obtained from the Conservation Division or its agents before plugging was commenced? YES

Name of Conservation Agent who supervised plugging of this well HUGH SCOTT  
Producing formation ST. LOUIS Depth to top 5794 Bottom 5925 Total Depth of Well 6060 Feet  
Show depth and thickness of all water, oil and gas formations.

OIL, GAS OR WATER RECORDS

CASING RECORD

FORMATION	CONTENT	FROM	TO	SIZE	PUT IN	PULLED OUT
ST. LOUIS	SMALL AMOUNT	5862	5870	8-5/8"	1720'	NONE
	OF GAS & OIL			3-1/2"	6057'	2780'
	& WATER					

Describe in detail the manner in which the well was plugged, indicating where the mud fluid was placed and the method or methods used in introducing it into the hole. If cement or other plugs were used, state the character of same and depth placed, from \_\_\_\_\_ feet to \_\_\_\_\_ feet for each plug set.

PLUGGED BACK TOTAL DEPTH 5925'

PUMPED 35 SACKS COMMON CEMENT INTO 3 1/2" PIPE. DISPLACED 10 SACKS INTO PERFORATION 5862-5870'. TOP OF PLUG AT 5358'. CUT OFF PIPE AT 2830'. PULLED CASING TO 670'. MUDDED UP WITH HEAVY MUD TO 670'. PUMPED IN 35 SACKS CEMENT TO 530'. PULLED PIPE. SET PLUG AT 40'. PUMPED 15 SACKS CEMENT FROM 40' TO GROUND LEVEL & WELDED ON STEEL CAP.

RECEIVED  
STATE CORPORATION COMMISSION

JUN 3 1963

CONSERVATION DIVISION  
Wichita, Kansas

(If additional description is necessary, use BACK of this sheet)  
Name of Plugging Contractor PETROLEUM, INC.,  
Address ROUTE 2, GREAT BEND, KANSAS

STATE OF KANSAS, COUNTY OF BARTON, ss.  
DON SEARLE (employee of owner) or (owner or operator) of the above-described well, being first duly sworn on oath, says: That I have knowledge of the facts, statements, and matters herein contained and the log of the above-described well as filed and that the same are true and correct. So help me God.  
(Signature) DON SEARLE, DIST. PROD. SUPT.  
ROUTE 2, GREAT BEND, KANSAS (Address)

SUBSCRIBED AND SWORN TO before me this 31st day of MAY, 19 63

APRIL 14, 1967

My commission expires

Arthur J. Nile  
Notary Public.

# WELL LOG

15-175-10089-0000

COMPANY Petroleum Inc

SEC. 1 T. 32 R. 32

FARM Dolven Unit NO. 2


LOC. C-SW-NE

TOTAL DEPTH 6060'

COUNTY Seward

COMM. 12-9-62 COMP. 1-6-63

CONTRACTOR Garvey Drilling Co

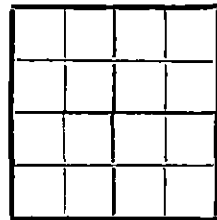

CASING 8 5/8" @ 1720' w/600 sx  
3 1/2" @ 6057' w/225 sx

ELEVATION 2840' D.F.

PRODUCTION Dry & Abandoned

FIGURES INDICATE BOTTOM OF FORMATIONS

70'	Surface Soil & Sand
536'	Sand & Gravel
780'	Red Bed
1350'	Red Bed & Sand
1720'	Red Bed & Anhydrite
1750'	Anhydrite
2450'	Shale & Shells
2885'	Shale & Lime
2960'	Lime & Shale
3044'	Lime
3210'	Shale & Lime
3830'	Chalky Lime & Shale
3926'	Shale & Lime
4295'	Lime & Shale
4348'	Lime
4408'	Lime & Shale
4843'	Lime
5300'	Lime & Shale
5355'	Lime
5528'	Lime & Shale
5570'	Shale, Sand & Lime
5755'	Lime & Shale
5805'	Lime
5875'	Lime & Shale
5910'	Lime, Chert & Shale
5990'	Lime & Shale
6060'	Lime
6060'	TD

RECEIVED  
STATE CORPORATION COMMISSION

JUN 3 1963

CONSERVATION DIVISION  
Wichita, Kansas

State of Kansas }  
County of Barton } ss

I, Vern A. Morris of Garvey Drilling Company

upon oath state the above and foregoing is a true and correct copy of the log of the #2 Dolven Unit well.

Subscribed and sworn to before me this 15th day of January 19 63

My Commission Expires: April 14th, 1963

Vern A. Morris  
Arthur J. [Signature]  
NOTARY PUBLIC