


Give All Information Completely
Make Required Affidavit
Mail or Deliver Report to:
Conservation Division
State Corporation Commission
211 No. Broadway
Wichita, Kansas

WELL PLUGGING RECORD

Seward County. Sec. 34 Twp. 32S Rge. 31W (E) (W)
Location as "NE/CNW/SW" or footage from lines C NE NE
Lease Owner Amarillo Natural Gas Co.
Lease Name Singley Well No. 1
Office Address Bank of the Southwest Bldg., Amarillo, Texas
Character of Well (completed as Oil, Gas or Dry Hole) D & A
Date well completed 8-16 1966
Application for plugging filed 8-18 1966
Application for plugging approved 8-18 1966
Plugging commenced 8-18 1966
Plugging completed 8-18 1966
Reason for abandonment of well or producing formation D & A

NORTH

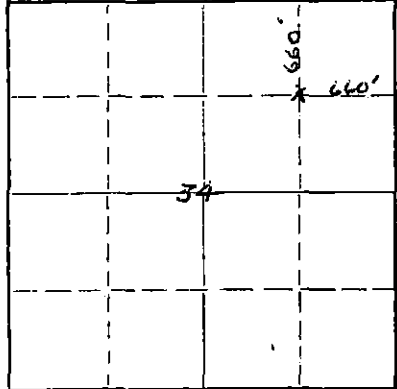

Locate well correctly on above Section Plat

If a producing well is abandoned, date of last production 19
Was permission obtained from the Conservation Division or its agents before plugging was commenced? Yes

Name of Conservation Agent who supervised plugging of this well Edgar Eves
Producing formation Depth to top Bottom Total Depth of Well 5270 Feet
Show depth and thickness of all water, oil and gas formations.

OIL, GAS OR WATER RECORDS

CASING RECORD

FORMATION	CONTENT	FROM	TO	SIZE	PUT IN	PULLED OUT
Surface				8 5/8	1332	None

Describe in detail the manner in which the well was plugged, indicating where the mud fluid was placed and the method or methods used in introducing it into the hole. If cement or other plugs were used, state the character of same and depth placed, from feet to feet for each plug set.

35 Sx @ 700' to 600'
15 Sx @ 45' to -0-

Plug set at 8:05 by Halliburton

RECEIVED
STATE CORPORATION COMMISSION

AUG 19 1966

CONSERVATION DIVISION
Wichita, Kansas

(If additional description is necessary, use BACK of this sheet)
Name of Plugging Contractor Mahoney Drilling Co., Inc.
Address Box 1257, Liberal, Kansas

STATE OF Kansas, COUNTY OF Seward, ss.
William F. Dean (employee of owner) or (owner or operator) of the above-described

well, being first duly sworn on oath, says: That I have knowledge of the facts, statements, and matters herein contained and the log of the above-described well as filed and that the same are true and correct. So help me God.

(Signature) William F. Dean

Box 1257, Liberal, Kansas
(Address)

SUBSCRIBED AND SWORN TO before me this 18 day of August, 1966

George W. Carnahan
Notary Public.

My commission expires January 24, 1968



15-175-00267-0000

RECEIVED
STATE CORPORATION COMMISSION

AUG 19 1966

CONSERVATION DIVISION
Wichita, Kansas

DRILLING LOG

LEASE OWNER Amarillo Natural Gas Co. ADDRESS Bank of the Southwest Bldg,
Amarillo, Texas
LEASE Singley #1 COUNTY Seward DESCRIPTION 34-32S-31W
C NE NE

CASING: SIZE 8 5/8 WEIGHT 23 AMOUNT 1332 KB

CEMENT: AMOUNT 700 Sx. CIRCULATED: Yes X No

CASING: SIZE _____ WEIGHT _____ AMOUNT _____

CEMENT: AMOUNT _____ Sx. CIRCULATED: Yes _____ No _____

PLUG SET: 700 Ft. TO 600 Ft. CEMENT 35 Sx.

45 Ft. TO 40- Ft. CEMENT 15 Sx.

FORMATION AND DEPTH

Surface Sand	0	TO	270
Surface Sand & Red Bed	270	TO	922
Red Bed & Sand	922	TO	1252
Red Bed & Shale	1252	TO	1333
Red Bed & Anhydrite	1333	TO	1748
Red Bed, Shale & Anhydrite	1748	TO	2383
Shale & Lime	2383	TO	4293
Lime	4293	TO	5160
Lime & Shale	5160	TO	5237
Lime	5237	TO	5270
Total Depth	5270	TO	
		TO	
		TO	
		TO	
		TO	

THIS IS A TRUE AND EXACT COPY OF THE FORMATIONS TAKEN FROM THE DAILY DRILLING REPORTS.

Executed this 18 day of August 19 66

By William F. Dean

IN WITNESS WHEREOF, I have hereunto set my hand and affixed my official seal the day and year above written.

George W. Carnahan Jr
Notary Public

MY COMMISSION EXPIRES: January 24, 1968