


WELL PLUGGING RECORD

Give All Information Completely  
Make Required Affidavit  
Mail or Deliver Report to:  
Conservation Division  
State Corporation Commission  
211 No. Broadway  
Wichita, Kansas

NORTH

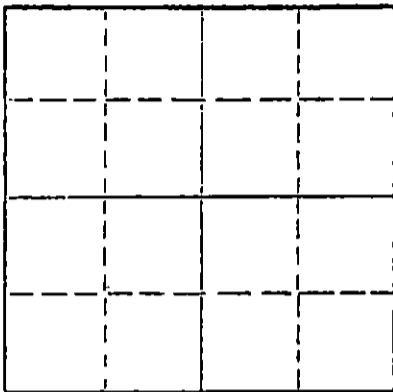

Locate well correctly on above  
Section Plat

Seward County, Sec. 32 Twp. 32S Rge. 31W (E) (W)

Location as "NE/CNW/SW" or footage from lines C SE NW

Lease Owner Anadarko Production Company

Lease Name Sherer "B" Well No. 1

Office Address Box 351, Liberal, Kansas

Character of Well (completed as Oil, Gas or Dry Hole) Dry Hole

Date well completed 2-15 19 65

Application for plugging filed 2-15 19 65

Application for plugging approved 2-15 19 65

Plugging commenced 2-15 19 65

Plugging completed 2-15 19 65

Reason for abandonment of well or producing formation

If a producing well is abandoned, date of last production 19

Was permission obtained from the Conservation Division or its agents before plugging was commenced? Yes

Name of Conservation Agent who supervised plugging of this well Hugh Scott

Producing formation Depth to top Bottom Total Depth of Well 6048 Feet

Show depth and thickness of all water, oil and gas formations.

OIL, GAS OR WATER RECORDS

CASING RECORD

FORMATION	CONTENT	FROM	TO	SIZE	PUT IN	PULLED OUT
				8-5/8"	1623'	

Describe in detail the manner in which the well was plugged, indicating where the mud fluid was placed and the method or methods used in introducing it into the hole. If cement or other plugs were used, state the character of same and depth placed, from feet to feet for each plug set.

Spotted 35 sacks cement at 700' and 15 sacks at 45'.

RECEIVED  
STATE CORPORATION COMMISSION

FEB 23 1965

CONSERVATION DIVISION  
Wichita, Kansas

(If additional description is necessary, use BACK of this sheet)

Name of Plugging Contractor Moran Brothers, Inc.

Address 1200 Oil & Gas Bldg., Wichita Falls, Texas

STATE OF KANSAS, COUNTY OF SEWARD, ss.

V. K. Downey, Asst. Supt. Drlg. & Prod. (employee of owner) or (owner or operator) of the above-described well, being first duly sworn on oath, says: That I have knowledge of the facts, statements, and matters herein contained and the log of the above-described well as filed and that the same are true and correct. So help me God

(Signature) V. K. Downey Asst. Supt. Drlg. & Prod.

Box 351 Liberal, Kansas  
(Address)

SUBSCRIBED AND SWORN TO before me this 19th day of February, 1965

Donald L. Vanjesson  
Notary Public.

My commission expires

DRILLER'S LOG

WELL NAME: Sherer "B" No. 1 ; COMPANY OPERATING: Anadarko Production Company  
 ADDRESS of COMPANY: Box 351, Liberal, Kansas

WELL LOCATION: C 1/4 SE 1/4 NW 1/4,  
660 ft. North of South line,  
660 ft. East of West line; Sec. 32, Twp. 32S, Rge. 31W, Seward County, Kansas

DRILLING STARTED 2-1, 1965; DRILLING COMPLETED 2-15, 1965  
 WELL COMPLETED 2-15, 1965; WELL CONNECTED \_\_\_\_\_, 19\_\_\_\_

ELEVATION: 2784.96 ft. Ground Level; CHARACTER OF WELL (Oil, Gas, or Dry Hole) Dry Hole

OIL OR GAS SANDS OR ZONES - PERFORATIONS - ACIDIZING AND FRACTURING INFORMATION					
Name	From	To	No. of Shots	Gallons Used	Kind Used

RECEIVED  
 STATE CORPORATION COMMISSION  
 FEB 23 1965  
 CONSERVATION DIVISION  
 Wichita, Kansas

CASING RECORD

Size	Amount Set	Sacks of Cement	Amount Pulled
8-5/8"	1623'	850	

FORMATION RECORD

Formation	Top	Bottom	Formation	Top	Bottom
Sand & Red Bed	0	800			
Red Bed, Gypsum & Sand	800	1624			
Anhydrite	1624	1647			
Shale & Red Bed	1647	2540			
Shale & Lime	2540	4440			
Lime	4440	5515			
Shale & Lime	5515	5615			
Lime	5615	6048			
Total Depth	6048				

RESULTS of INITIAL PRODUCTION TEST: \_\_\_\_\_