

15-175-00030-0000

STATE OF KANSAS
STATE CORPORATION COMMISSION


WELL PLUGGING RECORD

Give All Information Completely
Make Required Affidavit
Mail or Deliver Report to:
Conservation Division
State Corporation Commission
211 No. Broadway
Wichita, Kansas

Seward County, Sec. 31 Twp. 32 Rge. 31 (E) (W)

Location as "NE/CNW/SW" or footage from lines C SE
Lease Owner Panhandle Eastern Pipe Line Company
Lease Name Sherer Well No. 1-31
Office Address P.O. Box 351 Liberal, Kansas
Character of Well (completed as Oil, Gas or Dry Hole) Dry Hole
Date well completed February 16 19 59
Application for plugging filed February 16 19 59
Application for plugging approved February 16 19 59
Plugging commenced February 17 19 59
Plugging completed February 17 19 59
Reason for abandonment of well or producing formation Dry Hole

NORTH

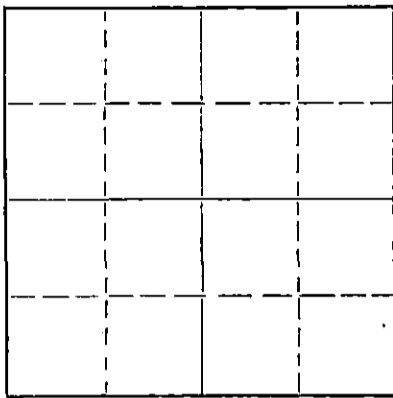

Locate well correctly on above
Section Plat

If a producing well is abandoned, date of last production _____ 19____
Was permission obtained from the Conservation Division or its agents before plugging was commenced? Yes

Name of Conservation Agent who supervised plugging of this well Merle Rives
Producing formation _____ Depth to top _____ Bottom _____ Total Depth of Well 5,850 Feet
Show depth and thickness of all water, oil and gas formations.

OIL, GAS OR WATER RECORDS

CASING RECORD

FORMATION	CONTENT	FROM	TO	SIZE	PUT IN	PULLED OUT
				8-5/8"	2,565'	None

Describe in detail the manner in which the well was plugged, indicating where the mud fluid was placed and the method or methods used in introducing it into the hole. If cement or other plugs were used, state the character of same and depth placed, from _____ feet to _____ feet for each plug set.

45 sacks spotted at 2,610 feet filled to 2,505 feet filled with mud to
480 feet spotted 45 sacks filled to 350 feet filled with mud to 30 feet
spotted 10 sacks filled to 5 feet of surface.

(If additional description is necessary, use BACK of this sheet)

Name of Plugging Contractor Lynn Drilling Company, Inc.
Address 1403 National Bank of Tulsa Building Tulsa, Oklahoma

STATE OF Kansas, COUNTY OF Seward, ss.
S. H. Neithercoat (employee of owner) or (owner or operator) of the above-described

well, being first duly sworn on oath, says: That I have knowledge of the facts, statements, and matters herein contained and the log of the above-described well as filed and that the same are true and correct. So help me God.

(Signature) S. H. Neithercoat
Liberal (Address)

SUBSCRIBED AND SWORN TO before me this 26th day of February 1959
Carl F. Halland

My Commission Expires November 14, 1960
My commission expires _____

Notary Public.

PLUGGING
FILE SEC. 31 T. 32 R. 31 W
BOOK PAGE 16 LINE 15

FEB 28 1959
CONSERVATION DIVISION
Wichita, Kansas

