

15-175-01009-0000


STATE OF KANSAS  
STATE CORPORATION COMMISSION

WELL PLUGGING RECORD

Give All Information Completely  
Make Required Affidavit  
Mail or Deliver Report to:  
Conservation Division  
State Corporation Commission  
211 No. Broadway  
Wichita, Kansas

Seward County, Sec. 31 Twp. 32S Rge. 31W (X) (W)

NORTH

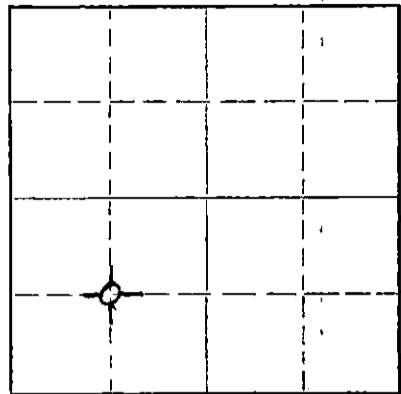

Locate well correctly on above  
Section Plat

Location as "NE/CNW/SW" or footage from lines C SW/4  
Lease Owner Ambassador Oil Corporation  
Lease Name Massoni Well No. 1  
Office Address 304 Hightower Building Oklahoma City, Oklahoma  
Character of Well (completed as Oil, Gas or Dry Hole) Dryhole  
Date well completed April 6, 19 60  
Application for plugging filed April 6, 19 60  
Application for plugging approved April 6, 19 60  
Plugging commenced April 6, 19 60  
Plugging completed April 7, 19 60  
Reason for abandonment of well or producing formation Dryhole

If a producing well is abandoned, date of last production ----- 19\_\_\_\_  
Was permission obtained from the Conservation Division or its agents before plugging was commenced? Yes

Name of Conservation Agent who supervised plugging of this well Mr. Frank Broadfoot  
Producing formation ----- Depth to top --- Bottom -- Total Depth of Well 5755 Feet  
Show depth and thickness of all water, oil and gas formations.

OIL, GAS OR WATER RECORDS

CASING RECORD

FORMATION	CONTENT	FROM	TO	SIZE	PUT IN	PULLED OUT
None				8 5/8	2446	None

Describe in detail the manner in which the well was plugged, indicating where the mud fluid was placed and the method or methods used in introducing it into the hole. If cement or other plugs were used, state the character of same and depth placed, from \_\_\_\_\_ feet to \_\_\_\_\_ feet for each plug set.

Hole was filled with heavy mud.  
100 sks. cement from 2550' - 2800'  
Heavy mud from 2440' - 2550'  
50 sks. cement from 2290' - 2440'  
Heavy mud from 400' - 2290'  
20 sks. cement from 360' - 400'  
Heavy mud from 35' - 360'  
10 sks. cement from 0' - 35' Completed @ 5 a.m. 4-7-60  
(Cut off 8 5/8" casing 3' below ground level)

STATE CLERK  
APR 18 1960  
DIVISION

(If additional description is necessary, use BACK of this sheet)  
Name of Plugging Contractor Garvey Drilling Co.  
Address Route 2 Great Bend, Kansas

STATE OF OKLAHOMA, COUNTY OF OKLAHOMA, ss.  
William R. Banks (employee of owner) or (owner or operator) of the above-described well, being first duly sworn on oath, says: That I have knowledge of the facts, statements, and matters herein contained and the log of the above-described well as filed and that the same are true and correct. So help me God.

(Signature) William R. Banks  
304 Hightower Building Oklahoma City, Okla.  
(Address)

Subscribed and Sworn to before me this 15th day of April, 19 60  
Lou Ann Huston  
Notary Public.

My commission expires January 28, 1962