


STATE OF KANSAS
STATE CORPORATION COMMISSION

Form CP-4

Give All Information Completely
Make Required Affidavit
Mail or Deliver Report to:
Conservation Division
State Corporation Commission
211 No. Broadway
Wichita, Kansas

WELL PLUGGING RECORD

NORTH

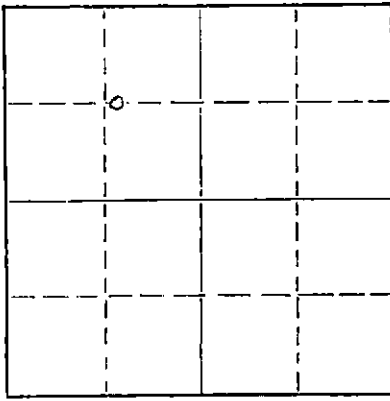Locate well correctly on above
Section Plat

Seward County. Sec. 30 Twp. 32W Rge. (E)31 (W)
 Location as "NE/CNW/SW" or footage from lines NE 1/4 C NW
 Lease Owner Whitestone Petroleum Corporation
 Lease Name M. L. BARNUM Well No. 1
 Office Address 900 Vaughn Bldg., Dallas 1, Texas
 Character of Well (completed as Oil, Gas or Dry Hole) Dry Hole
 Date well completed _____ 19____
 Application for plugging filed December 27 1962
 Application for plugging approved December 27 1962
 Plugging commenced December 28 1962
 Plugging completed December 29 1962
 Reason for abandonment of well or producing formation No Commercial Zones

If a producing well is abandoned, date of last production - - 19____
 Was permission obtained from the Conservation Division or its agents before plugging was commenced? Yes

Name of Conservation Agent who supervised plugging of this well Mr. Hugh Scott
 Producing formation - - Depth to top - - Bottom - - Total Depth of Well 6046 Feet
 Show depth and thickness of all water, oil and gas formations.

OIL, GAS OR WATER RECORDS

CASING RECORD

FORMATION	CONTENT	FROM	TO	SIZE	PUT IN	PULLED OUT
				16"	40'	0'
				8-5/8"	2291'	0'
				4-1/2"	5651'	2595'

Describe in detail the manner in which the well was plugged, indicating where the mud fluid was placed and the method or methods used in introducing it into the hole. If cement or other plugs were used, state the character of same and depth placed, from _____ feet to _____ feet for each plug set.

6046- 700' - Heavy Mud
 700- 600' - 35-Sack Plug
 600- 50' - Heavy Mud
 50- 0' - Rock Bridge w/15 Sacks Cement

RECEIVED
STATE CORPORATION COMMISSION

JAN 3 1963

CONSERVATION DIVISION

(If additional description is necessary, use BACK of this sheet)

Name of Plugging Contractor Sargents Casing Pulling Service
 Address 121 West Ninth Street, Liberal, Kansas

STATE OF TEXAS, COUNTY OF DALLAS, ss.
Dale O. Chase

(employee of owner) or (~~owner~~) of the above-described well, being first duly sworn on oath, says: That I have knowledge of the facts, statements, and matters herein contained and the log of the above-described well as filed and that the same are true and correct. So help me God.

(Signature)

Dale O. Chase900 Vaughn Bldg., Dallas 1, Texas

(Address)

SUBSCRIBED AND SWORN to before me this 2nd day of January, 1963Emmanuel Cady


Notary Public.

My commission expires 6/1/63

WELL LOG

M. L. BARNUM NO. 1
 WHITESTONE PETROLEUM CORPORATION
 DRILLING COMMENCED: 11-18-62
 DRILLING COMPLETED: 12-11-62

LOCATION: SEWARD, KANSAS

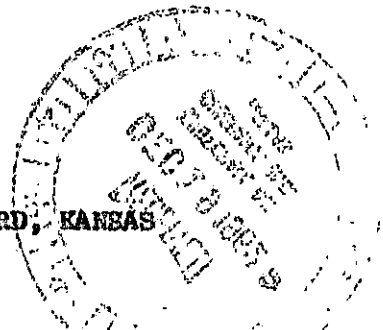

RECEIVED
 STATE CORPORATION COMMISSION

JAN 2 1963

CONSERVATION DIVISION
 Wichita, Kansas

Clay and sand strks.	0	619
Red bed	619	1051
Sand	1051	1236
Red bed	1236	1580
Red bed & anhydrite	1580	2294
Lime	2294	2710
Lime & sand	2710	2895
Lime	2895	3063
Lime & chalk	3063	3393
Lime	3393	3693
Chalk & lime	3693	3930
Lime	3930	4102
Dolomite	4102	4222
Lime	4222	4848
Lime & shale	4848	4953
Lime	4953	5592
Lime & shale	5592	5878
Hard lime	5878	5911
Lime	5911	5974
Sandy lime	5974	5998
Lime	5998	6046 T.D.

I, B. J. Gambrell, being first duly sworn on oath, state that I have knowledge of the facts and matter herein set forth and that the same are true and correct.

B. J. Gambrell
 B. J. Gambrell

Subscribed and sworn to before me this 17th day of December, 1962.

Lillian Exum
 Lillian Exum, Notary Public,
 Wichita County, Texas