

STATE OF KANSAS
STATE CORPORATION COMMISSION
CONSERVATION DIVISION
P. O. BOX 17027
WICHITA, KANSAS 67217

FORM CP-4

WELL PLUGGING RECORD

Seward County, Sec. 30 Twp. 32S Rge. (E) 31 (W)

Location as "NE/CNW/SE/SW" or footage from lines 660' FSL & 1980' FEL

Lease Owner Macey & Merston Oil, Inc.
Lease Name Cosner Well No. 1

Office Address Suite 1040, 1600 Broadway, Denver, Colorado 80202

Character of Well (completed as Oil, Gas or Dry Hole) Dry Hole

Date well completed 1/26 19 80

Application for plugging filed (letter 2/1/80) phone 1/26 19 80

Application for plugging approved phone 1/26 19 80


Plugging commenced 1/26 19 80

Plugging completed 11:30 PM 1/26 19 80

Reason for abandonment of well or producing formation

If a producing well is abandoned, date of last production 10

Was permission obtained from the Conservation Division or its agents before plugging was commenced? Yes

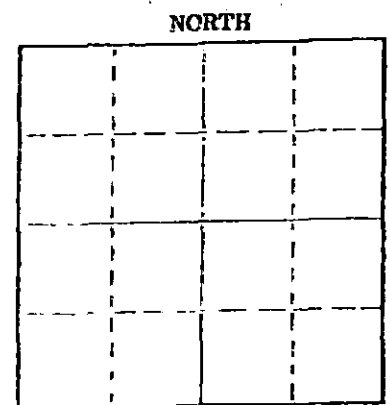

Locate well correctly on above Section Plat

Name of Conservation Agent who supervised plugging of this well Clarence Thomas, Garden City, Kansas

Producing formation _____ Depth to top _____ Bottom _____ Total Depth of Well 5975 Feet

Show depth and thickness of all water, oil and gas formations.

OIL, GAS OR WATER RECORDS


CASING RECORD

FORMATION	CONTENT	FROM	TO	SIZE	PUT IN	PULLED OUT
		0	1647	8 5/8	1647	0

Describe in detail the manner in which the well was plugged, indicating where the mud fluid was placed and the method or methods used in introducing it into the hole. If cement or other plugs were used, state the character of same and depth placed, from _____ feet to _____ feet for each plug set.

Filled hole with heavy mud to 1625 feet. Set first plug @ 1625 feet with 50 sacks cement. Filled hole with heavy mud to 800 feet. Set second plug @ 800 feet with 25 sacks cement. Filled hole with heavy mud to 40 feet, set third plug with 10 sacks cement. Plugged rat hole and mouse hole with five sacks cement each.

Name of Plugging Contractor: Zenith Drilling Corporation
Address: Suite 505, Fourth Financial Center, Wichita, Kansas 67202

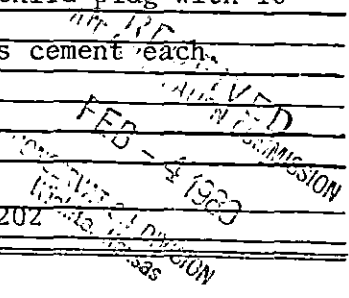

STATE OF KANSAS COUNTY OF SEDGWICK ss. Emmet E. Hall

(employee of owner) or (owner or operator) of the above-described well, being first duly sworn on oath, says: That I have knowledge of the facts, statements, and matters herein contained and the log of the above-described well as filed and that the same are true and correct. So help me God.

(Signature) *Emmet E. Hall*

505, Fourth Financial Center, Wichita, Kansas 67202 (Address)

Subscribed and sworn to before me this 1st day of February, 19 80

My commission expires 12/15/80 Sharon R. Allen Notary Public.

WELL LOG

COMPANY Macey & Mershon Oil, Inc.

SEC. 30-32S-31W

FARM Cosner NO. 1

LOC. 660' FSL & 1980' FEL

TOTAL DEPTH 5979


COUNTY Seward, Kansas

COMM. 1-14-80 COMP. 1-26-80

CONTRACTOR Zenith Drilling Corporation

CASING

1647' of 8-5/8", 24# casing, cemented with 1000 sacks cement

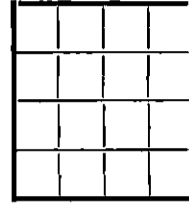

ELEVATION

PRODUCTION

FIGURES INDICATE BOTTOM OF FORMATIONS

- 132 Sand
- 1400 Sand & Red Bed
- 1648 Red Bed & Anhydrite
- 1950 Shells
- 2350 Sand & Shale
- 5975 Lime & Shale

Dry & Abandoned, Plugged 11:30 PM Jan. 26, 1980

NOTARY PUBLIC
FEB - 4 1980
Sharon R. Allen
Notary Public
Seward, Kansas

State of KANSAS }
County of SEDGWICK } ss

I, Emmet E. Hall of Zenith Drilling Corporation
upon oath state the above and foregoing is a true and correct copy of the log of the Cosner #1 well.

Emmet E. Hall

Subscribed and sworn to before me this 1st day of February, 1980.

My Commission Expires: 12/15/80

Sharon R. Allen
Sharon R. Allen NOTARY PUBLIC