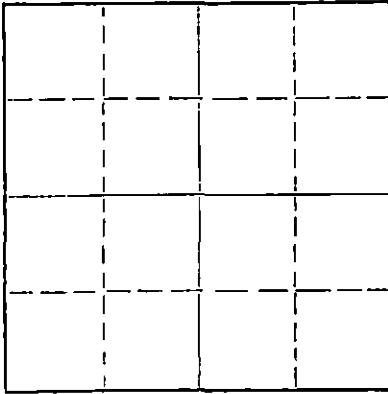


SP

STATE OF KANSAS  
STATE CORPORATION COMMISSIONGive All Information Completely  
Make Required Affidavit  
Mail or Deliver Report to:  
Conservation Division  
State Corporation Commission  
211 No. Broadway  
Wichita, Kansas

## WELL PLUGGING RECORD

NORTH

Locate well correctly on above  
Section Plat

Summer County. Sec. 19 Twp. 30S Rge. (E) 1 (W)  
 Location as "NE/CNW/SW" or footage from lines Approximately SE SE  
 Lease Owner Beardmore Drilling Company  
 Lease Name Dawe Well No. 2  
 Office Address 700 - 120 Building, Wichita, Kansas  
 Character of Well (completed as Oil, Gas or Dry Hole) Dry Hole  
 Date well completed 5-12 19 67  
 Application for plugging filed " 19 67  
 Application for plugging approved " 19 67  
 Plugging commenced " 19 67  
 Plugging completed " 19 67  
 Reason for abandonment of well or producing formation Dry hole

If a producing well is abandoned, date of last production 19  
 Was permission obtained from the Conservation Division or its agents before plugging was commenced?

Name of Conservation Agent who supervised plugging of this well Howard Hess  
 Producing formation Depth to top Bottom Total Depth of Well 3971 Feet  
 Show depth and thickness of all water, oil and gas formations.

## OIL, GAS OR WATER RECORDS

## CASING RECORD

FORMATION	CONTENT	FROM	TO	SIZE	PUT IN	PULLED OUT
Shale		0	135			
Shale & Shells		135	388	8 5/8	388'	-0-

Describe in detail the manner in which the well was plugged, indicating where the mud fluid was placed and the method or methods used in introducing it into the hole. If cement or other plugs were used, state the character of same and depth placed, from feet to feet for each plug set.

0 to 35' - 8 sacks cement

35' - Wood plug

35' to 190' - Heavy mud

190' to 250' - 20 sacks cement

250' - Wood plug

250' to 3971' - Heavy mud

Also: 2 sacks cement in rat hole

RECEIVED  
STATE CORPORATION COMMISSION

JUN 2 1967

CONSERVATION DIVISION  
Wichita, Kansas

(If additional description is necessary, use BACK of this sheet)

Name of Plugging Contractor Shawver-Armour, Inc.  
 Address 817 Central Building, Wichita, Kansas

STATE OF KANSAS, COUNTY OF SEDGWICK, ss.

Heber Beardmore (employee of owner) or (owner or operator) of the above-described well, being first duly sworn on oath, says: That I have knowledge of the facts, statements, and matters herein contained and the log of the above-described well as filed and that the same are true and correct. So help me God.

(Signature)

(Address)

SUBSCRIBED AND SWORN to before me this 31st day of May, 19 67

My commission expires 7-13-67

Shirley Ann Jackson

Notary Public.



D R I L L E R ' S L O G

FARM NAME:	DAWES #2	LOCATION:	Approx. SE SE-19-30S-1W Sumner County, Kansas
CONTRACTOR:	SHAWVER-ARMOUR, INC.		
OWNER:	BEARDMORE DRILLING CO.ELEVATION: 1290' K.B.		
COMMENCED:	April 27, 1967	COMPLETED:	May 12, 1967
CASING RECORD:	389' 8-5/8" w/300 sacks HA5 cement D & A - Plugged May 12, 1967		

FORMATION:

Top soil-clay	40
Shale-shells	135
Surface hole	389
Lime	720
Shale & lime shells	930
Shale-lime	1800
Lime-shale	2475
Shale-lime	2720
Lime-shale	2975
Lime	3510
Shale & lime	3604
Lime-shale	3643
Lime	3908
Shale & lime	3954
Lime & shale	3963
Simpson	3963
Rotary Total Depth	3971

D &amp; A

TOPS :

Stalnakersand	2760
Kansas City	3009
Cherokee	3494
Mississippi	3642
Simpson	3964

RECEIVED  
STATE CORPORATION COMMISSION  
JUN 2 1967  

STATE OF KANSAS                    }  
SEDGWICK COUNTY                }       SS

I, JAMES M. ARMOUR, do hereby certify that the above log is a true and correct copy of the above captioned well as shown on the daily drilling reports.

SHAWVER-ARMOUR, INC.

By James M. Armour  
James M. Armour

Subscribed and sworn to before me this  
16th day of May, 1967.

My commission expires Dec. 29, 1967

Marjorie Hall  
Marjorie Hall, Notary Public