


WELL PLUGGING RECORD

Give All Information Completely  
Make Required Affidavit  
Mail or Deliver Report to:  
Conservation Division  
State Corporation Commission  
212 No. Market  
Wichita, Kansas

Meade County, Sec. 36 Twp. 32 Rge. (E) 30(W)  
Location as "NE/CNWSW" or footage from lines C SW SW  
Lease Owner Colorado Oil Company  
Lease Name Krause Well No. 1  
Office Address 915 Union Natl. Bldg., Wichita, Kansas 67202  
Character of Well (completed as Oil, Gas or Dry Hole) Oil  
Date well completed March 16 1957  
Application for plugging filed Dec. 23 1970  
Application for plugging approved Dec. 24 1970  
Plugging commenced Feb. 15 1971  
Plugging completed Feb. 17 1971  
Reason for abandonment of well or producing formation Depleted

If a producing well is abandoned, date of last production July 10 1969  
Was permission obtained from the Conservation Division or its agents before plugging was commenced? Yes

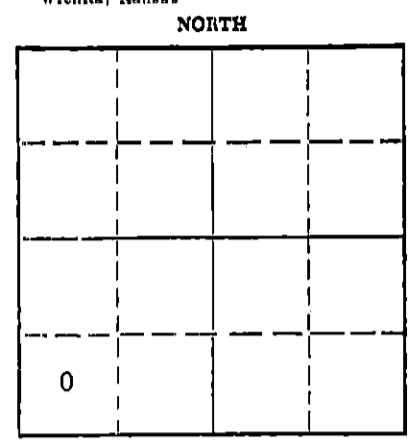

Name of Conservation Agent who supervised plugging of this well E. Eves  
Producing formation Morrow Depth to top 5642 Bottom 5719 Total Depth of Well 5835 Feet  
Show depth and thickness of all water, oil and gas formations.

OIL, GAS OR WATER RECORDS				CASING RECORD		
FORMATION	CONTENT	FROM	TO	SIZE	PUT IN	PULLED OUT
				8-5/8"	1629	None
				5-1/2"	5749	3111

Describe in detail the manner in which the well was plugged, indicating where the mud fluid was placed and the method or methods used in introducing it into the hole. If cement or other plugs were used, state the character of same and depth placed, from \_\_\_\_\_ feet to \_\_\_\_\_ feet for each plug set.

Mixed 20 sacks cement + 1 sack hulls to plug off perms @ 5666'.  
Top plug @ 5500'.  
Pump 35 sacks cement @ 1000' to 900'.  
Put 15 sacks cement @ 45' to 0'.

RECEIVED  
STATE CORPORATION COMMISSION  
MAR 16 1971  
CONSERVATION DIVISION  
Wichita, Kansas

(If additional description is necessary, use BACK of this sheet)  
Name of Plugging Contractor Sargents Casing Pulling Service  
Address P. O. Box 506, Liberal, Kansas 67901

STATE OF Kansas COUNTY OF Sedgwick, ss.  
Bill K. Henrichs (employee of owner) or (owner or operator) of the above-described well, being first duly sworn on oath, says: That I have knowledge of the facts, statements, and matters herein contained and the log of the above-described well as filed and that the same are true and correct. So help me God.

(Signature) Bill K. Henrichs [Signature]  
915 Union Natl. Bldg., Wichita, Kansas 67202  
(Address)

SUBSCRIBED AND SWORN TO before me this 15th day of March, 1971

Betty J. McElwain  
Betty J. McElwain Notary Public.  
My commission expires February 19, 1973


WELL LOG BUREAU—KANSAS GEOLOGICAL SOCIETY  
508 East Murdock, Wichita, Kansas

Company- COLORADO OIL & GAS COMPANY  
Farm- Krause No. 1

SEC. 36 T. 32 R. 30W  
C SW SW

Total Depth. 5835  
Comm. 2-14-57 Comp. 3-12-57  
Shot or Treated. Sand Frac  
Contractor. Nye & Snell  
Issued. 5-4-57

County Meade KANSAS

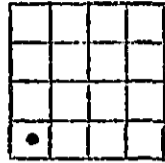

CASING:  
8 5/8" 1628' cem w/800 sx.  
5 1/2" 5749' cem w/100 sx.

Elevation. 2724 R.B.

Production. 3000 BOPD

Figures indicate Bottom of Formations.

sand, red bed	665
red bed, shells	1390
shells, anhydrite	1550
anhydrite	1643
anhydrite, shells	2346
lime, shale	3153
lime chalky, shale	3265
shale, lime	4080
lime	4185
lime, shale	4578
lime	4610
lime, shale	4815
lime	4920
lime, shale	5170
lime	5200
lime, shale	5657
Coring	5700
lime, shale	5835
Total Depth	

Tops: Scout	
Lansing	4518
Morrow	4636
Mississippian	5716

RECEIVED  
STATE CORPORATION COMMISSION  
DEC 24 1970  
CONSERVATION DIVISION  
Wichita, Kansas

