


STATE OF KANSAS  
STATE CORPORATION COMMISSION

WELL PLUGGING RECORD

All Information Completely  
Make Required Affidavit  
Mail or Deliver Report to:  
Conservation Division  
State Corporation Commission  
211 No. Broadway  
Wichita, Kansas

Meade County. Sec. 36 Twp. 32 Rge. 30 (~~X~~) (W)  
Location as "NE/CNW%SW%" or footage from lines C NW SE  
Lease Owner Fred Collingwood  
Lease Name Collingwood Well No. 2  
Office Address Box 134, Garden City, Kansas  
Character of Well (completed as Oil, Gas or Dry Hole) Dry Hole  
Date well completed July 26, 1957 19  
Application for plugging filed July 26, 1957 19  
Application for plugging approved July 26, 1957 19  
Plugging commenced July 26, 1957 19  
Plugging completed July 27, 1957 19  
Reason for abandonment of well or producing formation Dry hole

NORTH

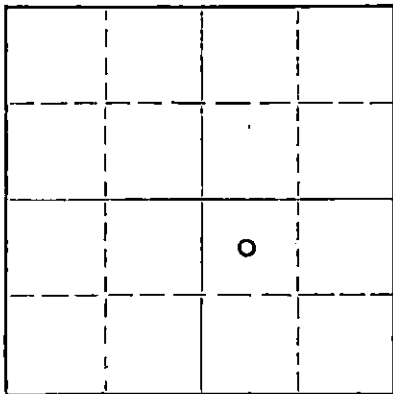

Locate well correctly on above  
Section Plat

If a producing well is abandoned, date of last production None 19  
Was permission obtained from the Conservation Division or its agents before plugging was commenced? Yes

Name of Conservation Agent who supervised plugging of this well M. A. Rives  
Producing formation None Depth to top \_\_\_\_\_ Bottom \_\_\_\_\_ Total Depth of Well 5820 Feet  
Show depth and thickness of all water, oil and gas formations.

OIL, GAS OR WATER RECORDS

CASING RECORD

FORMATION	CONTENT	FROM	TO	SIZE	PUT IN	PULLED OUT
				8-5/8	1544.28	None

Describe in detail the manner in which the well was plugged, indicating where the mud fluid was placed and the method or methods used in introducing it into the hole. If cement or other plugs were used, state the character of same and depth placed, from \_\_\_\_\_ feet to \_\_\_\_\_ feet for each plug set.

Filled with heavy mud 5820-600'  
Filled with 25 sacks cement 600-525'  
Filled with mud 525- 30'  
Plugged with cement 30-Surface

(If additional description is necessary, use BACK of this sheet)

Name of Plugging Contractor Garvey Drilling Company  
Address 311 East Third, Wichita, Kansas

STATE OF KANSAS, COUNTY OF FINNEY, ss.  
R. W. Lange (employee of owner) or (owner or operator) of the above-described well, being first duly sworn on oath, says: That I have knowledge of the facts, statements, and matters herein contained and the log of the above-described well as filed and that the same are true and correct. So help me God.

(Signature) R. W. Lange  
Box 134, Garden City, Kansas  
(Address)

SUBSCRIBED AND SWORN to before me this 29 day of July, 19 57

My commission expires August 13, 1960

Darlene Brody  
Notary Public  
STATE COM. \_\_\_\_\_

PLUGGING  
FILE SEC 36 T. 32 R. 30W  
BOOK PAGE 31 LINE 43

JUL 31 1957  
CONSERVATION DIVISION  
Wichita, Kansas

# WELL LOG

COMPANY **FRED COLLINGWOOD**

SEC. 36 T. 32S R. 30W

FARM **F. COLLINGWOOD** NO. **2**

LOC. **C/NW,SE**


TOTAL DEPTH **5820'**

COUNTY **Meade Co., Kansas**

COMM. **July 4, 1957**

COMP. **July 27, 1957**

CONTRACTOR **GARVEY DRILLING COMPANY**

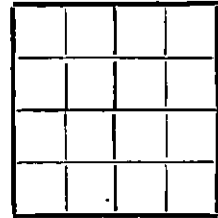

CASING

ELEVATION

PRODUCTION **D & A**

FIGURES INDICATE BOTTOM OF FORMATIONS

65	Clay & sand
635	Sand
675	Shells & red bed
1060	Red bed, shale & shells
1496	Red bed & sand
1525	Anhydrite
2205	Shale & shells
2365	Lime & shale
2409	Lime & chert w/shale
3011	Lime & shale
3061	Lime
3946	Lime & shale
3986	Lime
4104	Lime & shale
4230	Lime w/shale streaks
4270	Lime
4586	Lime w/shale
4645	Lime
4717	Chalky lime
4922	Lime w/shale streaks
5070	Lime
5203	Lime & shale
5273	Lime
425335	Lime & shale
5680	Lime
5730	Sand
5820	Lime & shale
5820	T. D.

**RECEIVED**  
 STATE CORPORATION COMMISSION  
 NOV 23 1957  
 CONSERVATION DIVISION  
 Wichita, Kansas

**PLUGGING**  
 FILE SEC. 36 T. 32 R. 30W  
 BOOK PAGE 21 LINE 43

State of KANSAS }  
 County of BARTON } ss:

I, Verne A. Morris of Garvey Drilling Co.

upon oath state that the above and foregoing is a true and correct copy of the log of the #2 F. Collingwood well

*Verne A. Morris*

Subscribed and sworn to before me this 13th day of August 19 57

My Commission Expires: November 12, 1958

*[Signature]*  
 NOTARY PUBLIC