

15-119-10124-0000

STATE OF KANSAS
STATE CORPORATION COMMISSION


WELL PLUGGING RECORD

Give All Information Completely
Make Required Affidavit
Mail or Deliver Report to:
Conservation Division
State Corporation Commission
211 No. Broadway
Wichita, Kansas

Meade County. Sec. 36 Twp. 32 Rge. (E) 30 (W)

Location as "NE/CNW%SW%" or footage from lines C SE/4 NW/4
Lease Owner Peerless Oil & Gas Company
Lease Name Bachman Well No. 4
Office Address P. O. Box 245 - Hooker, Oklahoma
Character of Well (completed as Oil, Gas or Dry Hole) Dry Hole
Date well completed January 30 19 58
Application for plugging filed January 30 19 58
Application for plugging approved by telephone - J. P. Roberts, Jan. 30 19 58
Plugging commenced January 30 @ 3:30 p.m. 19 58
Plugging completed January 30 @ 7:30 p.m. 19 58
Reason for abandonment of well or producing formation Dry hole

NORTH

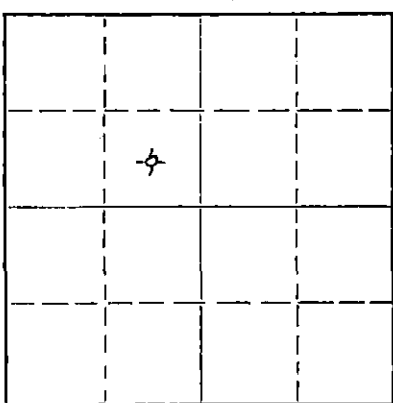

Locate well correctly on above Section Plat

If a producing well is abandoned, date of last production 19
Was permission obtained from the Conservation Division or its agents before plugging was commenced? Yes - by telephone to J.P. Roberts & Merle A. Rives

Name of Conservation Agent who supervised plugging of this well Merle A. Rives
Producing formation None Depth to top - 0 - Bottom - 0 - Total Depth of Well 5800' Feet
Show depth and thickness of all water, oil and gas formations.

OIL, GAS OR WATER RECORDS

CASING RECORD

FORMATION	CONTENT	FROM	TO	SIZE	PUT IN	PULLED OUT
Tertiary Sand	Water	150'	500'	9-5/8"	1611'	None
RECEIVED STATE CORPORATION COMMISSION FEB 9 1958 CONSERVATION DIVISION						

Describe in detail the manner in which the well was plugged, indicating where the mud fluid was placed and the method or methods used in introducing it into the hole. If cement or other plugs were used, state the character of same and depth placed, from feet to feet for each plug set.

After logging well, hole filled with heavy mud. Set cement plug with drill pipe from 5769' to 5364' which consisted of 125 sacks of common cement. Set a top plug from 1600' to 1471' with 50 sacks of common cement. The top plug is near the bottom of the 9-5/8" casing. Cement pumped by Halliburton Cementers of Liberal, Kansas. The well was completed with a mud weight of 9.2 and viscosity of 65 with mud in very good condition and both cement jobs displaced with this same type mud, leaving heavy mud in the open formation and heavy mud in the surface casing above both plugs.

Officially plugged well by welding cap on top of 9-5/8" casing 4 feet below ground level. King's Welding Service of Guymon, Oklahoma, placed cap on well on February 6, 1958, at 11:00 a.m. Well officially plugged as of February 6, 1958.

Used 800 sacks of Pozmix #1 to cement 9-5/8" casing. Cement circulated on this casing making it impossible to pull any of the casing.

(If additional description is necessary, use BACK of this sheet)

Name of Plugging Contractor Midwestern Drillers, Inc.
Address 1206 Mid-Continent Building - Tulsa, Oklahoma

STATE OF Kansas, COUNTY OF Meade, ss.
Clyde W. Thompson (employee of owner) or (owner or operator) of the above-described well, being first duly sworn on oath, says: That I have knowledge of the facts, statements, and matters herein contained and the log of the above-described well as filed and that the same are true and correct. So help me God.

(Signature) Clyde W. Thompson General Superintendent
Peerless Oil & Gas Co. - Hooker, Oklahoma
Box 245 (Address)

SUBSCRIBED AND SWORN to before me this 7th day of February, 1958

Eldena Mustens Notary Public.

My commission expires January 7, 1960

PLUGGING
FILE SEC 36 T 32 R 300
BOOK PAGE 80 LINE 20