


Give this information Completely
Make Required Affidavit
Mail or Deliver Report to:
Conservation Division
State Corporation Commission
P. O. Box 17027
Wichita, Kansas 67217
NORTH

WELL PLUGGING RECORD

Meade County, Sec. 35 Twp. 32S Rge. 30 (E) (W) X

Location as "NE/CNW/SW" or footage from lines G SW SE
Lease Owner McAdams Pipe & Supply Co.
Lease Name Holmes Well No. 8
Office Address Drawer 960 Bristow, Oklahoma 74010
Character of Well (completed as Oil, Gas or Dry Hole) Oil
Date well completed August 9 19 56
Application for plugging filed Jan. 29 19 74
Application for plugging approved Jan. 31 19 74
Plugging commenced March 6 19 74
Plugging completed March 7 19 74
Reason for abandonment of well or producing formation Depleted

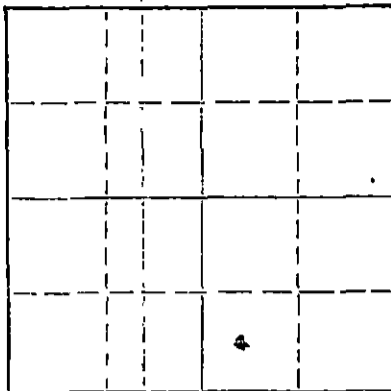

Locate well correctly on above Section Plat

If a producing well is abandoned, date of last production October 10 19 66
Was permission obtained from the Conservation Division or its agents before plugging was commenced? Yes

Name of Conservation Agent who supervised plugging of this well Ed Eves
Producing formation Morrow Depth to top 5652 Bottom 5687 Total Depth of Well 5886 Feet
Show depth and thickness of all water, oil and gas formations.

OIL, GAS OR WATER RECORDS

CASING RECORD

FORMATION	CONTENT	FROM	TO	SIZE	PUT IN	PULLED OUT
				8 5/8	1614	none
				5 1/2	5875	2850

Describe in detail the manner in which the well was plugged, indicating where the mud fluid was placed and the method or methods used in introducing it into the hole. If cement or other plugs were used, state the character of same and depth placed, from feet to feet for each plug set.

Pump 20 sks. of cement to 5500
Pump 35 sks. of cement @ 1000 to 900
Put 15 sks. of cement @ 45 to 0

RECEIVED
STATE CORPORATION COMMISSION
MAR 28 1974
CONSERVATION DIVISION
Wichita, Kansas

(If additional description is necessary, use BACK of this sheet)
Name of Plugging Contractor Sargents Casing Pulling Service Kansas No. 511
Address Box 506 Liberal, Kansas 67901

STATE OF OKLAHOMA, COUNTY OF CREEK, ss.
T. P. McAdams, Jr. (employee of owner) (or (owner or operator) of the above-described well, being first duly sworn on oath, says: That I have knowledge of the facts, statements, and matters herein contained and the log of the above-described well as filed and that the same are true and correct. So help me God.

(Signature) [Signature]
P. O. Drawer 960 - Bristow, Okla. 74010
(Address)

SUBSCRIBED AND SWORN TO before me this 26th day of March 19 74

My commission expires September 23, 1975 [Signature] Notary Public.

WELL LOG BUREAU—KANSAS GEOLOGICAL SOCIETY
502 East Murdock, Wichita, Kansas


COPY

Company- COLORADO OIL & GAS
Farm- Holmes No. 8

SEC. 35 T. 32 R. 30W
C SW SE

Total Depth. 5886'
Comm. 7-15-56 Comp. 8-7-56
Shot or Treated.
Contractor. Mye & Snell DrLg. Co.
Issued. 11-17-56

County Meade
KANSAS

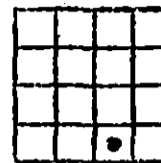

CASING:
8 5/8" 1627'
5 1/2" 5875'

Elevation. 2733'

Production. 530 BOPD

Figures indicate Bottom of Formations

sand-shells	254
sand	521
red rock	590
red rock-shells	1524
shale-anhydrite	1960
shale-shells	2475
chert-lime-shale	2605
lime	2665
lime-shale	2835
lime	2950
lime-shale	3040
lime	3115
chalky lime	3200
lime-shale	3300
chalky lime-shale	3415
chalky lime	3545
lime-shale	3875
lime	3925
lime-shale	4072
chert-lime	4105
lime	4150
lime-shale	4215
lime	4280
lime-shale	4525
lime	4545
lime-shale	4904
chert-lime-shale	5120
lime	5155
lime-chert	5220
lime-shale	5271
lime	5310
lime-shale	5410
lime-chert	5445
lime-shale	5563
chert-lime	5605
lime-sand	5664
lime-shale-sand	5690
lime	5815
lime-shale	5865
lime	5886
Total Depth	

TOPS: Scout	
Herrington	2672
Lansing	4517
Marmaton	5142
Morrow	5626
Morrow sand	5650
Mississippi	5698

RECEIVED
STATE CORPORATION COMMISSION
JAN 30 1974
CONSERVATION DIVISION
Wichita, Kansas