


15-119-10083-0000

STATE OF KANSAS
STATE CORPORATION COMMISSION

Give All Information Completely
Make Required Affidavit
Mail or Deliver Report to:
Conservation Division
State Corporation Commission
211 No. Broadway
Wichita, Kansas

WELL PLUGGING RECORD

NORTH

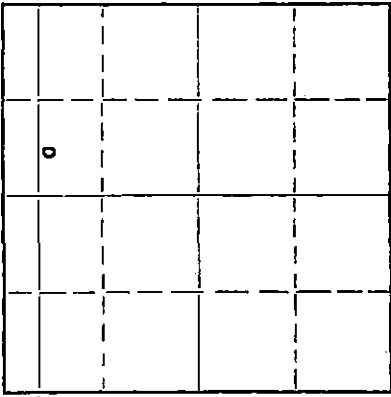

Locate well correctly on above
Section Plat

Meade County, Sec. 35 Twp. 32S Rge. 30 (X) (W)
Location as "NE/CNW/SW" or footage from lines Approx. C SW/4 NW/4
Lease Owner Graham-Michaelis Drilling Company
Lease Name Vail Well No. 1
Office Address 211 North Broadway, Wichita 2, Kansas
Character of Well (completed as Oil, Gas or Dry Hole) Dry Hole
Date well completed 8/15 19 59
Application for plugging filed 9/3 19 59
Application for plugging approved 19
Plugging commenced 8/15 19 59
Plugging completed 8/15 19 59
Reason for abandonment of well or producing formation Dry and Abandoned

If a producing well is abandoned, date of last production none 19
Was permission obtained from the Conservation Division or its agents before plugging was commenced? yes

Name of Conservation Agent who supervised plugging of this well Merle A. Rives
Producing formation Depth to top Bottom Total Depth of Well 5760 RTW feet
Show depth and thickness of all water, oil and gas formations.

OIL, GAS OR WATER RECORDS

CASING RECORD

FORMATION	CONTENT	FROM	TO	SIZE	PUT IN	PULLED OUT
				8 5/8	1640	none

Describe in detail the manner in which the well was plugged, indicating where the mud fluid was placed and the method or methods used in introducing it into the hole. If cement or other plugs were used, state the character of same and depth placed, from feet to feet for each plug set.

Set bottom plug at 800' with 20 sacks common cement. Mudded hole to 40'. Set top plug at 40' with 15 sacks common cement.

RECEIVED
STATE CORPORATION COMMISSION
SEP 8 1959
CONSERVATION DIVISION
Wichita, Kansas

(If additional description is necessary, use BACK of this sheet)

Name of Plugging Contractor Graham-Michaelis Drilling Company
Address 211 North Broadway, Wichita 2, Kansas

STATE OF KANSAS, COUNTY OF SEDGWICK, ss.
Jack L. Yinger (employee of owner) or (owner/lessee/operator) of the above-described well, being first duly sworn on oath, says: That I have knowledge of the facts, statements, and matters herein contained and the log of the above-described well as filed and that the same are true and correct. So help me God.

(Signature) Jack L. Yinger
Jack L. Yinger
211 North Broadway, Wichita 2, Kansas
(Address)

SUBSCRIBED AND SWORN TO before me this 4th day of September, 19 59

Betty Jean Good
Betty Jean Good Notary Public.

My commission expires Sept. 20, 1961



PLUGGING

File Sec. 35 T. 32 R. 30 W
Book Page 1 Line 44

VAIL #1

WELL RECORD:

LOCATION: C SW NW Sec. 35-T32S-R30W Commenced: 7/21/59
 Meade County, Kansas Completed: 8/15/59
 (Rotary)

CONTRACTOR: Graham-Michaelis Drilling Co.
 211 North Broadway
 Wichita 2, Kansas

CASING RECORD: Cemented 8 5/8" Casing w/800
 sx pozmis & common

	<u>LOG</u>
Sub Soil, Clay & Sand	0 - 1018
Sand, Gyp & Red Bed	1018 - 1391
Shale, Shells & Red Bed	1391 - 1640
Shale & Shells	1640 - 2558
Lime & Shale	2558 - 4087
Lime	4087 - 4204
Lime & Shale	4204 - 5627
Lime, Shale, & Sand	5627 - 5675
Lime & Shale	5675 - 5760

RECEIVED
 STATE CORPORATION COMMISSION
 SEP 4 1959
 CONSERVATION DIVISION
 Wichita, Kansas

5760' - Total Rotary Depth

The undersigned, Graham-Michaelis Drilling Company, hereby certifies that the above log is a true and correct log of the formations encountered in drilling the above well as reflected by the Daily Drilling Report.

GRAHAM-MICHAELIS DRILLING COMPANY

By *John L. Johnson*
 (Geologist)

PLUGGING

File Sec. 35 T. 32 R. 30W
 Book Page 1 Line 44

RECEIVED
 STATE CORPORATION COMMISSION
 SEP 4 1959
 CONSERVATION DIVISION
 Wichita, Kansas