


STATE OF KANSAS  
STATE CORPORATION COMMISSION

Give All Information Completely  
Make Required Affidavit  
Mail or Deliver Report to:  
Conservation Division  
State Corporation Commission  
P. O. Box 17027  
Wichita, Kansas 67217  
NORTH

WELL PLUGGING RECORD

Location as "NE/CNW/SE/SW" or footage from lines Meade County, Sec. 35 Twp. 32S Rge. 20 (E) (W) X  
Lease Owner McAdams Pipe & Supply Co.  
Lease Name Holmes Well No. 9  
Office Address Drawer 960 Bristow, Oklahoma 74010  
Character of Well (completed as Oil, Gas or Dry Hole) Oil  
Date well completed Sept 16, 1966  
Application for plugging filed Jan 29, 1974  
Application for plugging approved Jan 31, 1974  
Plugging commenced March 3, 1974  
Plugging completed March 5, 1974  
Reason for abandonment of well or producing formation Depleted

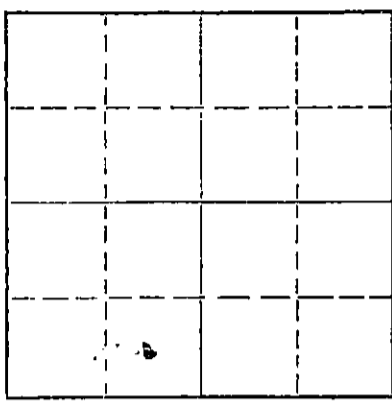

Locate well correctly on above Section Plat

If a producing well is abandoned, date of last production November 19 66  
Was permission obtained from the Conservation Division or its agents before plugging was commenced? Yes

Name of Conservation Agent who supervised plugging of this well Ed Eves  
Producing formation Mississippi Depth to top 5713 Bottom 5754 Total Depth of Well 5810 Feet  
Show depth and thickness of all water, oil and gas formations.

OIL, GAS OR WATER RECORDS

CASING RECORD

FORMATION	CONTENT	FROM	TO	SIZE	PUT IN	PULLED OUT
				8 5/8	1622	none
				5 1/2	5797	2827

Describe in detail the manner in which the well was plugged, indicating where the mud fluid was placed and the method or methods used in introducing it into the hole. If cement or other plugs were used, state the character of same and depth placed, from \_\_\_\_\_ feet to \_\_\_\_\_ feet for each plug set.

Pump 40 sks. of cement to 5500  
Pump 35 sks. of cement @ 1000 to 900  
Put 15 sks. of cement @ 45 to 0

RECEIVED  
STATE CORPORATION COMMISSION  
MAR 28 1974  
CONSERVATION DIVISION  
Wichita, Kansas

(If additional description is necessary, use BACK of this sheet)  
Name of Plugging Contractor Sargents Casing Pulling Service Kansas No. 511  
Address Box 506 Liberal, Kansas 67901

STATE OF OKLAHOMA, COUNTY OF CREEK, ss.  
T. P. McAdams, Jr. (employee of owner) or (owner or operator) of the above-described well, being first duly sworn on oath, says: That I have knowledge of the facts, statements, and matters herein contained and the log of the above-described well as filed and that the same are true and correct. So help me God.

(Signature) [Signature]  
P. O. Drawer 960 - Bristow, Oklahoma 74010  
(Address)

SUBSCRIBED AND SWORN TO before me this 26th day of March, 19 74

My commission expires September 23, 1975 Notary Public.

STENCILED

WELL LOG BUREAU—KANSAS GEOLOGICAL SOCIETY  
508 East Murdock, Wichita, Kansas

ORIGINAL


NOV 17 1955

Company- COLORADO OIL & GAS Co.  
Farm- Holmes No. 9

SEC. 35 T. 32 R. 30W  
C SE SW

Total Depth. 5810'  
Comm. 8-12-56 Comp. 9-5-56  
Shot or Treated.  
Contractor. Snell Drlg. Co.  
Issued. 11-17-56

County Meade  
KANSAS

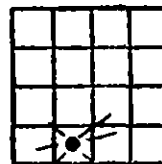

Elevation. 2735' DE

Production. 3,500,000 CFGPD

Figures indicate Bottom of Formations.

sand	71
sand	518
red bed	575
red bed-shells	1400
red bed-anhydrite	1580
shale-anhydrite	1634
anhydrite	1860
shale-anhydrite	2110
shale	2370
chert-lime-shale	2500
lime-chert	2575
shale -lime	3030
lime	3100
shale-lime	3395
chalky lime	3537
lime-shale	3580
lime	3725
lime-shale	3885
lime	3935
lime-shale	4085
lime	4135
lime-shale	4175
lime	4280
lime-shale	4395
lime	4567
lime-shale	4605
lime	4700
lime-shale	4765
lime	4880
lime-shale	4980
lime	5040
lime-shale	5215
lime	5270
lime-shale	5310
lime	5415
lime-shale	5464
lime	5560
lime-shale	5605
lime	5667
Core #1	5675
Coring	5718
shale-lime	5810
Total Depth	

TOPS; Scout	
Lansing	4538
Marmaton	5138
Cherokee	5300
Atoka	5444
Morrow shale	5605
Mississippi	5668

RECEIVED  
STATE CORPORATION COMMISSION  
JAN 30 1974  
CONSERVATION DIVISION  
Wichita, Kansas