

15-119-10007-0000

Ro

STATE OF KANSAS
STATE CORPORATION COMMISSION


WELL PLUGGING RECORD

Give All Information Completely
Make Required Affidavit
Mail or Deliver Report to:
Conservation Division
State Corporation Commission
211 No. Broadway
Wichita, Kansas

Meade County, Sec. 34 Twp. 32S Rge. (E) 30 (W)

Location as "NE/CNW&SW" or footage from lines NE SW SW
Lease Owner Humble Oil & Refining Co., Carter Division
Lease Name Behnke-Vail Well No. 1
Office Address Box 786, Great Bend, Kansas
Character of Well (completed as Oil, Gas or Dry Hole) Gas
Date well completed 10-10 19 59
Application for plugging filed 19
Application for plugging approved 19
Plugging commenced 12-12 19 59
Plugging completed 12-16 19 59
Reason for abandonment of well or producing formation Uneconomical

NORTH

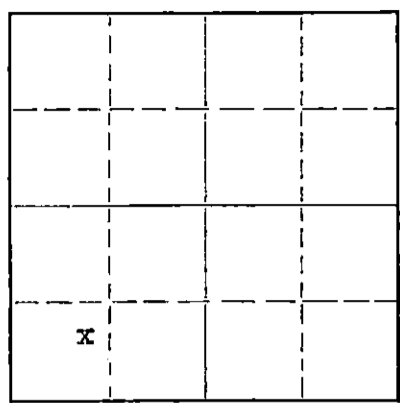

Locate well correctly on above
Section Plat

If a producing well is abandoned, date of last production 8-21 19 59
Was permission obtained from the Conservation Division or its agents before plugging was commenced? Yes

Name of Conservation Agent who supervised plugging of this well Mr. Bill Lac-Kamp
Producing formation Morrow Depth to top 5620' Bottom 5640' Total Depth of Well 5800' Feet
Show depth and thickness of all water, oil and gas formations.

OIL, GAS OR WATER RECORDS

CASING RECORD

FORMATION	CONTENT	FROM	TO	SIZE	PUT IN	PULLED OUT
Morrow Sand	Gas	5620'	5640'	8-5/8"	1543'	0'
				5-1/2" (15.5#)	530'	0'
				5-1/2" (11#)	5300'	3085'

Describe in detail the manner in which the well was plugged, indicating where the mud fluid was placed and the method or methods used in introducing it into the hole. If cement or other plugs were used, state the character of same and depth placed, from _____ feet to _____ feet for each plug set.

Filled with Chat & Sand 5685-5600, 5 sax Cement from 5600-5560, Rotary Mud 5560 to 650', Rock Bridge 650-640', 20 sax Cement 640-578', Heavy Rotary Mud 578'-50', Rock Bridge 40'-30', 10 sax Cement 30' to 4' below G.L.

RECEIVED
STATE CORPORATION COMMISSION
JAN 11 1960
CONSERVATION DIVISION
Wichita, Kansas

(If additional description is necessary, use BACK of this sheet)

Name of Plugging Contractor Toland & Reeves
Address _____

STATE OF Kansas COUNTY OF Barton, ss.
J. D. Simmons (employee of owner) or (owner or operator) of the above-described

well, being first duly sworn on oath, says: That I have knowledge of the facts, statements, and matters herein contained and the log of the above-described well as filed and that the same are true and correct. So help me God.

(Signature) J. D. Simmons
J. D. SIMMONS, District Supt.
Box 786, Great Bend, Kansas
(Address)

SUBSCRIBED AND SWORN TO before me this 8th day of January, 19 60

My commission expires 8-19-61

Wm. H. Knisley
Notary Public.



THE CARTER OIL COMPANY
Great Bend, Kansas

0+5 15-119-10007-0000

Behnke-Vail Unit Well No. 1, Center of NE S¹/₄ SW Section
34-32S-30W, Meade County, Kansas

CASING RECORD:

1546' of 8 5/8" 900 Sacks - SET CSG @ 1546'
5800' of 5 1/2" 250 Sacks - SET CSG @ 5797'

COMM DRLG 8-22-56
COMPLETED DRLG 9-14-56
CALCULATED OPEN FLOW
POTENTIAL 1020 MCF/DAY

FORMATIONS:	TOP	BOTTOM
Sand, Clay, Shell	0	245
Sand and Clay	245	503
Sand and Red Bed	503	800
Red Shale	800	980
Red Bed and Sand	980	1210
Sand, Shale, Anhydrite	1210	1506
Anhydrite	1506	1550
Sand and Shale	1550	2130
Shale and Sand	2130	2400
Shale and Lime	2400	2593
Lime and Shale	2593	2717
Chalky Lime and Shale	2717	2810
Chalky Lime	2810	2924
Shale and Lime	2924	2978
Lime and Shale	2978	3066
Shale and Lime	3066	3093
Lime	3093	3235
Lime and Shale	3235	3582
Lime	3582	3655
Lime and Shale	3655	3917
Shale and Lime	3917	4333
Lime and Shale	4333	4415
Shale and Lime	4415	4535
Lime, Shale, Chert	4435	4570
Lime and Shale	4570	4620
Shale and Lime	4620	4673
Lime and Shale	4673	4797
Lime	4797	4852
Lime and Shale	4852	4912
Lime	4912	4949
Lime and Shale	4949	5085
Broken Lime and Shale	5085	5175
Lime and Shale	5175	5327
Lime	5327	5372
Lime and Shale	5372	5490
Lime	5490	5575
Shale and Lime	5575	5618
Sand and Lime	5618	5621
Lime	5621	5652
Lime, Shale, Sand	5652	5685
Lime and Shale	5685	5725
Lime and Shale	5725	5794
Lime	5794	5800

MARMATON 5101
CHEROKEE 5300
MORROW FMN 5604
MORROW SD 5620
CHESTER 5694

RECEIVED
STATE COMMISSION
AUG 16 1959
CONSERVATION DIVISION
Wichita, Kansas

PLUGGING
FILE SEC 34 T 32 R 30W
BOOK PAGE 58 LINE 20