

15-119-10080-0000


STATE OF KANSAS
STATE CORPORATION COMMISSION

Form CP-4

WELL PLUGGING RECORD

Give All Information Completely
Make Required Affidavit
Mail or Deliver Report to:
Conservation Division
State Corporation Commission
211 No. Broadway
Wichita, Kansas

Meade County. Sec. 34 Twp. 32s Rge. 30 W (E) (W)
Location as "NE/CNW/SW" or footage from lines C se se
Lease Owner Graham - Michaelis Drilling Co.
Lease Name Jones Well No. B # 1
Office Address -Box--1294- 211 North Broadway, Wichita, Kansas
Character of Well (completed as Oil, Gas or Dry Hole) Gas
Date well completed 1-27 19 58
Application for plugging filed 5-3 19 66
Application for plugging approved 5-4 19 66
Plugging commenced 5-19 19 66
Plugging completed 5-21 19 66
Reason for abandonment of well or producing formation Non commercial

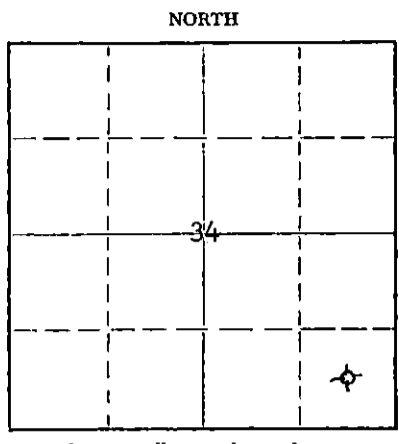

Locate well correctly on above
Section Plat

If a producing well is abandoned, date of last production April 30, 1966
Was permission obtained from the Conservation Division or its agents before plugging was commenced? Yes

Name of Conservation Agent who supervised plugging of this well Edd Eaves
Producing formation Morrow Depth to top. 5645 Bottom 5657' Total Depth of Well 5820 Feet
Show depth and thickness of all water, oil and gas formations.

OIL, GAS OR WATER RECORDS

CASING RECORD

FORMATION	CONTENT	FROM	TO	SIZE	PUT IN	PULLED OUT
				8 5/8	1545	none
				5 1/2	5819	3025

Describe in detail the manner in which the well was plugged, indicating where the mud fluid was placed and the method or methods used in introducing it into the hole. If cement or other plugs were used, state the character of same and depth placed, from _____ feet to _____ feet for each plug set.

Mix 20 sacks cement to plug off perforations at 5702 feet.
Stop plug at 5600 feet. Shoot pipe loose at 3025 and pull to 700 feet. Spot 35 sacks cement at 700 feet to 600 feet. Finish pulling 5 1/2 inch casing. Put 15 sacks cement at 45 feet to 0 feet. Cut off 8 5/8 casing 3 feet below ground level and cap same.

RECEIVED
STATE CORPORATION COMMISSION

MAY 25 1966

CONSERVATION DIVISION
Wichita, Kansas

(If additional description is necessary, use BACK of this sheet)


Name of Plugging Contractor Sargent's Casing Pulling Service
Address Box 506 Liberal, Kansas

STATE OF Kansas COUNTY OF Sedgwick, ss.
W. A. Michaelis, Jr. (employee of owner) or (owner or operator) of the above-described well, being first duly sworn on oath, says: That I have knowledge of the facts, statements, and matters herein contained and the log of the above-described well as filed and that the same are true and correct. So help me God.

(Signature) W.A. Michaelis, Jr.
211 North Broadway, Wichita, Kansas
(Address)

Subscribed and sworn to before me this 24th day of May, 19 66
My commission expires December 12, 1966

Evelyn D. Evans
Evelyn D. Evans
Notary Public.

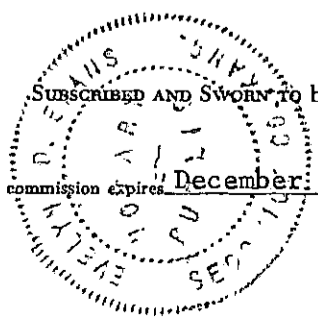

JONES "A" #1

Well Record

Location: C 3E SE Section 34-T925-R30W
 Deado County, Kansas
 Commenced: December 8, 1937
 Completed: January 2, 1938
 (rotary)

Operator: Graham-Michaels Drilling Co.
 311 North Broadway
 Wichita, Kansas

Contractor: Graham-Michaels Drilling Co.
 311 North Broadway
 Wichita, Kansas

Casing Record: 3 5/8" #1545° W/600 sacks cement
 5 1/2" #5810° W/150 sacks cement

	<u>LOG</u>
Sand	1030
Sand, Red bed & Anhy.	1298
Red bed	1646
Sand, Shale	1945
Red bed & Shale	2354
Shale & Lime	2650
Shled Lime Shells	3030
Shale & Lime	3380
Lime & Shale	3435
Lime, Shale & Chalk	3678
Lime & Shale	3760
Lime & Sandy Shale	3937
Lime & Shale	3994
Lined shale	4125
Lime & Shale	4570
Lime	4686
Lime & Shale	47713
Lime & Chalk	4816
Lime & Shale	5346
Lime	5576
Lime & Shale	5769
Lime & Shale	5820, RTD.

RECEIVED
 STATE CORPORATION COMMISSION

JUN 19 1966

STATE OF KANSAS)
) ss.
 COUNTY OF SEDGWICK)

The undersigned, GRAHAM-MICHAELIS DRILLING COMPANY, hereby certifies that the above log is a true and correct log of the formations encountered in drilling the above well as reflected by the Daily Drilling Report.

GRAHAM-MICHAELIS DRILLING COMPANY

By John L. James
 John L. James, Geologist.

Subscribed and sworn to before me
 this 10th day of January, 1938.

J. D. Grier
 My commission expires: 1/7/31.