


STATE OF KANSAS CORPORATION COMMISSION

WELL PLUGGING RECORD

Give All Information Completely Make Required Affidavit Mail or Deliver Report to: Conservation Division State Corporation Commission 211 No. Broadway Wichita, Kansas

Meade County, Sec. 33 Twp. 32 Rge. (E) 30 (W) Location as "NE/CNW/SW" or footage from lines SW NE Lease Owner Champlin Oil and Refining Company Lease Name Herman C. Bender Well No. 1 Office Address P. O. Box 552, Enid, Oklahoma Character of Well (completed as Oil, Gas or Dry Hole) Dry Hole Date well completed April 3 19 57 Application for plugging filed April 3 19 57 Application for plugging approved April 3 19 57 Plugging commenced April 3 19 57 Plugging completed April 3 19 57 Reason for abandonment of well or producing formation

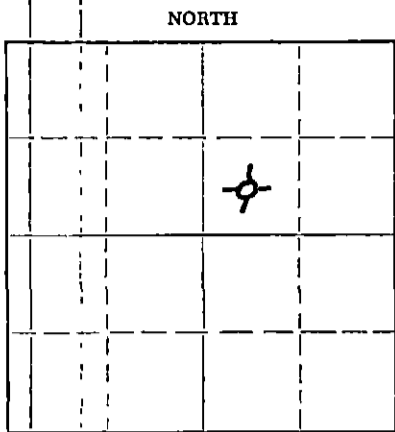

Locate well correctly on above Section Plat

If a producing well is abandoned, date of last production 19 Was permission obtained from the Conservation Division or its agents before plugging was commenced? Yes

Name of Conservation Agent who supervised plugging of this well M. A. Rives Producing formation Depth to top Bottom Total Depth of Well 5750 Feet Show depth and thickness of all water, oil and gas formations.

OIL, GAS OR WATER RECORDS

CASING RECORD

Table with 7 columns: FORMATION, CONTENT, FROM, TO, SIZE, PUT IN, PULLED OUT. One entry: SIZE 8 5/8", PUT IN 1815, PULLED OUT None.

Describe in detail the manner in which the well was plugged, indicating where the mud fluid was placed and the method or methods used in introducing it into the hole. If cement or other plugs were used, state the character of same and depth placed, from feet to feet for each plug set.

Hole filled W/heavy mud to 1820' #1 plug set W/20 sks cement, Halliburton process, filled W/heavy mud to 30', plug set W/10 sks cement to surface

Used Halliburton to plug well.

Name of Plugging Contractor Earl F. Wakefield (Plugging License #199) Address 515 Union Center Bldg., Wichita, Kansas

STATE OF Kansas, COUNTY OF Sedgwick, ss. J. W. Meyers (employee of owner) of the above-described well, being first duly sworn on oath, says: That I have knowledge of the facts, statements, and matters herein contained and the log of the above-described well as filed and that the same are true and correct. So help me God.

(Signature) J. W. Meyers 306 Koch Building, Wichita, Kansas (Address)

SUBSCRIBED AND SWORN to before me this 26th day of November 19 57

My commission expires February 22, 1961 M. Kenneth Stivers Notary Public.



STATE COMMISSION NOV 27 11-27-57 CONSERVATION DIVISION Wichita, Kan

PLUGGING FILE SEC 33 T 32 R 30W BOOK PAGE 3 LINE 42

CHAMPLIN OIL & REFINING CO.

Herman C. Bender #1
 CSW $\frac{1}{4}$ NE $\frac{1}{4}$ Sec. 33-T 32 S- R 30W

FORMATION RECORD

TOPS - BOTTOM

0 - 125	Surface Soil and sand
125 - 750	Sand and shale
750 - 991	Red Bed and lime shells
991 - 1356	Red Bed-lime stks
1356 - 1510	Shale and lime stks
1510 - 1650	Anhydrite
1650 - 1805	Shale and anhydrite
1805 - 1998	Shale and Red Bed
1998 - 2312	Shale, dolomite and anhydrite
2312 - 2709	Shale and lime
2709 - 2747	Lime and chert stks
2747 - 2869	Sandy lime and shale, anhydrite
2869 - 2915	Shale, and stks of anhydrite
2915 - 3019	Lime and shale
3019 - 3106	Lime, shale and chalky lime
3106 - 3185	Chalky lime, stks chert
3185 - 3418	Lime, shale, stks chalky lime
3418 - 3600	Chalky lime
3600 - 3610	Lime
3610 - 3674	Shale and lime
3674 - 3961	Shale and chalky lime
3961 - 4006	Lime, shale, chert
4006 - 4046	Marbelized lime and chert
4046 - 4060	Lime and chert
4060 - 4150	Lime, shale, stks of chalky lime
4150 - 4214	Lime and shale
4214 - 4308	Black shale
4308 - 4445	Lime and shale
4445 - 4500	Chalky lime and shale
4500 - 4515	Lime and shale
4515 - 4564	Lime
4564 - 4615	Chalky lime and shale
4615 - 4923	Lime and shale
4923 - 4940	Lime
4940 - 4965	Shale
4965 - 5014	Chalk and shale
5014 - 5053	Chalky lime and shale
5053 - 5394	Lime and shale
5394 - 5463	Shale, stks lime
5463 - 5573	Lime and shale
5573 - 5597	Lime and shale-sand
5597 - 5640	Shale
5640 - 5672	Shale and sand
5672 - 5702	Shale
5702 - 5750	Shale and lime
5750	Total Depth

Geological Tops

Lansing-KC	4500
Base/KC	5067
Marmaton	5131
Cherokee	5296
Base/Cherokee	
Atoka Sd.	5587-90
Morrow	5592
Morrow Sd.	5608-30
Miss. (Chester)	5658

Subscribed and sworn to before me
 this 26th day of November, 19 57

J. Meyers
 District Superintendent

My Commission expires February 22, 1961

N. Kenneth Stearns
 Notary Public

RECORDED
 INDEXED
 OCT 15 1957
 WICHITA, KANSAS

PLUGGING
 FILE SEC 33 T 32 S 30W
 BOOK PAGE 3 LINE 42