

STATE OF KANSAS
STATE CORPORATION COMMISSION

WELL PLUGGING RECORD

Give All Information Completely
Make Required Affidavit
Mail or Deliver Report to:
Conservation Division
State Corporation Commission
211 No. Broadway
Wichita, Kansas

Meade County. Sec. 33 Twp. 32S Rge. (E) 30 (W)

Location as "NE/CNW/SW" or footage from lines SE/4 SE/4 SE/4

Lease Owner Aladdin Petroleum Corp.

Lease Name Wail Well No. 1

Office Address 809 Petroleum Building, Wichita 2, Kansas

Character of Well (completed as Oil, Gas or Dry Hole) Gas

Date well completed December 12 19 55

Application for plugging filed June 23 19 60

Application for plugging approved June 24 19 60


Plugging commenced July 11 19 60

Plugging completed July 19 19 60

Reason for abandonment of well or producing formation Not profitable

If a producing well is abandoned, date of last production April 19 60

Was permission obtained from the Conservation Division or its agents before plugging was commenced? yes

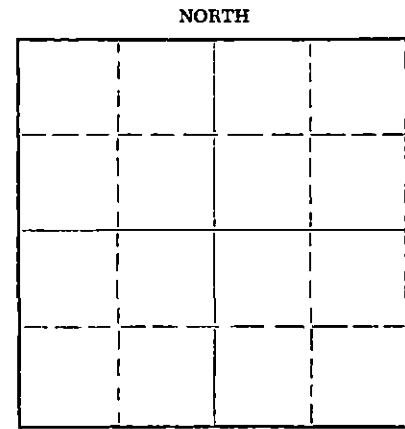

Locate well correctly on above Section Flat

Name of Conservation Agent who supervised plugging of this well Frank Broad Foot

Producing formation Morrow Sand Depth to top Bottom Total Depth of Well 5744 Feet

Show depth and thickness of all water, oil and gas formations.

OIL, GAS OR WATER RECORDS

CASING RECORD

FORMATION	CONTENT	FROM	TO	SIZE	PUT IN	PULLED OUT
				13-3/8	636	none
				8-5/8	2710	none
				5-1/2	5744	3595

Describe in detail the manner in which the well was plugged, indicating where the mud fluid was placed and the method or methods used in introducing it into the hole. If cement or other plugs were used, state the character of same and depth placed, from feet to feet for each plug set.

Filled with sand 5706 to 5560
 5 sacks cement 5560 to 5530
 mudded 5530 to 2690
 rock bridge 2690 to 2680
 10 sacks cement 2680 to 2650
 mudded 2650 to 500
 rock bridge 500 to 490
 20 sacks cement 490 to 440
 mudded 440 to 40
 rock 40 to 30
 10 sacks cement 30 to base of cellar

RECEIVED
STATE CORPORATION COMMISSION

JUL 28 1960

CONSERVATION DIVISION
Wichita, Kansas

(If additional description is necessary, use BACK of this sheet)

Name of Plugging Contractor Glenn & Smith Pipe Pulling Co.

Address Box 114, Ellinwood, Kansas

STATE OF Kansas, COUNTY OF Sedgwick, ss.

J. M. Johnson (employee of owner) or (owner or operator) of the above-described well, being first duly sworn on oath, says: That I have knowledge of the facts, statements, and matters herein contained and the log of the above-described well as filed and that the same are true and correct. So help me God.

(Signature) J. M. Johnson

J. M. Johnson (Address)

SUBSCRIBED AND SWORN TO before me this 27th day of July, 19 60

Adela Petrik (Notary Public)

My commission expires Nov. 5, 1962



Company: Aladdin Petroleum Corp. - Vail #1
Contractor: Dutch George Drilling Company
Location: SE SE SE Section 33-32-30, Keade County, Kansas

0 - 126	Red beds and sand
126 - 434	Red beds
434 - 620	Red beds and shells
620 - 636	Red beds and shale
636 - 645	Lime and shells
645 - 840	Red beds
840 - 1060	Red beds and chalk
1060 - 1165	Sand
1165 - 1225	Red beds and sand
1225 - 1490	Red beds and shells
1490 - 1595	Shale and lime streaks
1595 - 1715	Lime and red beds
1715 - 1820	Lime
1820 - 1910	Lime and red beds
1910 - 2050	Lime
2050 - 2135	Lime and shale
2135 - 2195	Lime
2195 - 2340	Lime and shale
2340 - 2355	Lime
2355 - 2450	Lime and shale
2450 - 2485	Lime
2485 - 2520	Lime and red shale
2520 - 2570	Lime
2570 - 2586	Lime - Cherty
2586 - 2660	Lime
2660 - 2670	Anhydrite and Lime
2670 - 2755	Lime & Shale
2755 - 2910	Lime sand and shale
2910 - 3155	Lime
3155 - 3233	Lime & Shale
3233 - 3280	Lime
3280 - 3320	Lime and shale
3320 - 3385	Sandy shale
3385 - 3565	Sandy lime and shale
3565 - 3585	Lime
3585 - 3715	Lime and shale
3715 - 3790	Sandy shale
3790 - 3830	Chalky lime
3830 - 3903	Lime
3903 - 4075	Shale and lime streaks
4075 - 4095	Lime
4095 - 4120	Black shale
4120 - 4140	Shale and lime
4140 - 4196	Lime
4196 - 4310	Lime and shale
4310 - 4340	Chalky lime
4340 - 4410	Sandy shale and lime
4410 - 4488	Lime
4488 - 4515	Lime and shale
4515 - 4589	Sandy lime

Commenced: October 5, 1955
Completed: November 11, 1955 (Rotary)
December 12, 1955 (cable)

Cag. Record: 13 3/8@636' with 600 sacks.
8 5/8@2706' with 1600 sacks.
5 1/2@5744' with 300 sacks.

Tops: Lansing 4497'
Marmaton Limestone 5117'
Atoka 5373'
Morrow: 5570'
ELEV: 2743' KB
2735' GL
Total Depth: 5744'

Production: 47,250MCF per day.

Perforated 40 holes from 5596' to 5606'
72 holes from 5612' to 5630'

RECEIVED
STATE CORPORATE COMMISSION
JUL 28 1960
CONSERVATION DIVISION
WICHITA, KANSAS

DRILLERS LOG

Aladdin Petroleum Corp. - Vail #1

(Continued)

4589 - 4643	Lime and chalk
4643 - 4713	Lime
4713 - 4745	Sandy lime
4745 - 4790	Chally lime
4790 - 4911	Lime
4911 - 4955	Lime and shale
4955 - 4999	Porous lime
4999 - 5040	Lime and shale
5040 - 5089	Lime
5089 - 5165	Lime and shale
5165 - 5240	Lime
5240 - 5285	Lime and shale
5285 - 5350	Lime
5350 - 5485	Lime and shale
5485 - 5513	Lime
5513 - 5581	Lime and shale
5581 - 5633	Coring
5633 - 5670	Sand
5678 - 5735	Lime

RECEIVED
STATE CORPORATION COMMISSION

JUL 28 1960
COMMISSIONER

I, the under-signed, J.S. George, hereby certify that the above is a true Drillers Log on Aladdin Petroleum Corp. Vail #1, Section 33-32-30, Meade County, Kansas.

STATE OF Kansas, COUNTY OF Delaware SS.

Subscribed and Sworn to before me this 16th day of February, 1956.

Virginia Munnell
Notary Public

My Commission Expires August 10, 1957.