

15-119-00062-0000


STATE OF KANSAS
STATE CORPORATION COMMISSION

WELL PLUGGING RECORD

Give All Information Completely
Make Required Affidavit
Mail or Deliver Report to:
Conservation Division
State Corporation Commission
211 No. Broadway
Wichita, Kansas

MEADE County. Sec 27 Twp. 32 Rge 30 (W) (W)
Location as "NE/CNW/SW" or footage from lines SE SE NW
Lease Owner PETROLEUM, INC.
Lease Name HOLMES "C" Well No. 1
Office Address Route 2, Great Bend, Kansas
Character of Well (completed as Oil, Gas or Dry Hole) Dry Hole
Date well completed August 31, 1957
Application for plugging filed September 3, 1957
Application for plugging approved August 31, 1957
Plugging commenced August 31, 1957
Plugging completed August 31, 1957
Reason for abandonment of well or producing formation No producible zones

NORTH

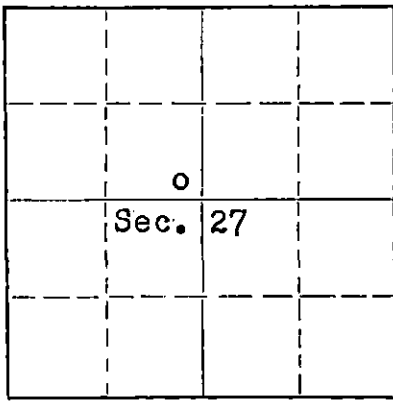

Locate well correctly on above
Section Plat

If a producing well is abandoned, date of last production None 19
Was permission obtained from the Conservation Division or its agents before plugging was commenced? Yes

Name of Conservation Agent who supervised plugging of this well M.A. Rives Box 8, Pratt, Kansas
Producing formation --- Depth to top --- Bottom --- Total Depth of Well 5715 Feet
Show depth and thickness of all water, oil and gas formations.

OIL, GAS OR WATER RECORDS

CASING RECORD

FORMATION	CONTENT	FROM	TO	SIZE	PUT IN	PULLED OUT
				8-5/8"	1527'	None

Describe in detail the manner in which the well was plugged, indicating where the mud fluid was placed and the method or methods used in introducing it into the hole. If cement or other plugs were used, state the character of same and depth placed, from feet to feet for each plug set.
Mud up to 550', pushed down 1/3 sack hulls to 550' followed by wooden plug. Placed 20 sacks cement through drill pipe on to plug. Mud up to 35' and place 1/3 sack hulls to 35' followed by wooden plug and 10 sacks cement to base of well cellar.

9-13-57

(If additional description is necessary, use BACK of this sheet)
Name of Plugging Contractor Garvey Drilling Company
Address Route 2, Great Bend, Kansas

STATE OF KANSAS, COUNTY OF BARTON, ss.
Don Searle (employee of owner) or (conservation agent) of the above-described well, being first duly sworn on oath, says: That I have knowledge of the facts, statements, and matters herein contained and the log of the above-described well as filed and that the same are true and correct. So help me God.
(Signature) Don Searle
Route 2, Great Bend, Kansas (Address)

SUBSCRIBED AND SWORN to before me this 12th day of September 1957

My commission expires July 11, 1960 Notary Public.

PLUGGING
FILE SEC 27 T. 32 R. 30W
BOOK PAGE 41 LINE 32

WELL LOG

15-119-00062-0000

COMPANY PETROLEUM, INCORPORATED

SEC. 27 T. 32S R. 30W

FARM HOLMES "C" NO. 1


LOC. SE, SE, NW

TOTAL DEPTH 5715'

COUNTY Meade Co., Kansas

COMM. August 7, 1957 COMP. August 31, 1957

CONTRACTOR GARVEY DRILLING COMPANY

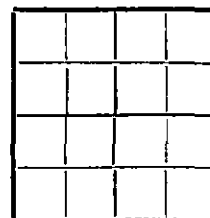

CASING 8 5/8" @ 1527' W/900 sax.

ELEVATION 2750' DF

PRODUCTION D & A

FIGURES INDICATE BOTTOM OF FORMATIONS

140	Shale & Sand
225	Shale & shells;
952	Shale & sand
1510	Red bed & sand
1527	Anhydrite
1925	Red bed
2175	Shale & shells
2354	Shale
2570	Lime
2762	Lime & shale
2781	Lime
2920	Shale w/chalky lime
3377	Lime
3708	Lime & shale
3830	Chalky lime
4189	Lime
4490	Shale & lime
4533	Lime
4580	Lime w/shale
4648	Lime
4715	Chalky lime
5220	Lime
5269	Lime w/shale streaks
5715	Lime
5715	T. D.

RECORDED
STATE COM.

SEP 13 1957

CONSERVATION DIVISION
Wichita, Kansas

PLUGGING	
FILE	SEC. 27 T. 32 R. 30W
BOOK	PAGE 41 LINE 32

State of KANSAS }
County of BARTON } ss:

I, Verne A. Morris of Garvey Drilling Co.

upon oath state that the above and foregoing is a true and correct copy of the log of the #1 Holmes "C" well

Verne A. Morris

Subscribed and sworn to before me this 10th day of September 19 57

My Commission Expires: July 11, 1960

Jed T. Brown
NOTARY PUBLIC