


STATE OF KANSAS
STATE CORPORATION COMMISSION

Give All Information Completely
Make Required Affidavit
Mail or Deliver Report to:
Conservation Division
State Corporation Commission
211 No. Broadway
Wichita, Kansas

RECEIVED
STATE CORPORATION COMMISSION
DIVISION
JUL 20 1957

WELL PLUGGING RECORD

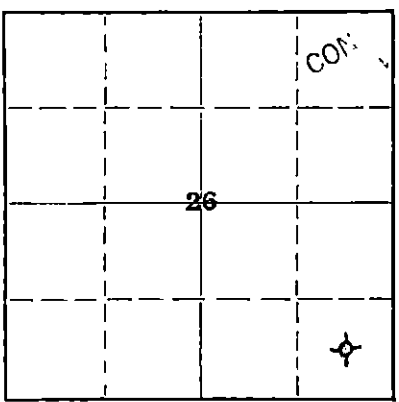

Locate well correctly on above
Section Flat

Location as Meade County. Sec. 26 Twp. 32S Rge. 30 (X) W (W)
Location as "NE/CNWSW" or footage from lines C SE SE
Lease Owner The R. W. Rine Drilling Company and Colorado Oil and Gas Corporation
Lease Name Collingwood Well No. 1
Office Address 420 Union Center Building, Wichita 2, Kansas
Character of Well (completed as Oil, Gas or Dry Hole) Dry Hole
Date well completed July 16, 19 57
Application for plugging filed July 16, 19 57
Application for plugging approved July 16, 19 57
Plugging commenced July 17, 19 57
Plugging completed July 17 @ 12:00 Noon, 19 57
Reason for abandonment of well or producing formation Dry Hole

If a producing well is abandoned, date of last production - 19 -
Was permission obtained from the Conservation Division or its agents before plugging was commenced? Yes

Name of Conservation Agent who supervised plugging of this well M. A. Rives, Pratt, Kansas
Producing formation - Depth to top - Bottom - Total Depth of Well 5782 Feet
Show depth and thickness of all water, oil and gas formations.

OIL, GAS OR WATER RECORDS

CASING RECORD

FORMATION	CONTENT	FROM	TO	SIZE	PUT IN	PULLED OUT
Sand and shale	water	0	450			
Shale, gyp, red bed	-	450	875			
Red bed, sand	water	875	1300			
Sand and gyp	water	1300	1370	8-5/8"	1605'	None

Describe in detail the manner in which the well was plugged, indicating where the mud fluid was placed and the method or methods used in introducing it into the hole. If cement or other plugs were used, state the character of same and depth placed, from _____ feet to _____ feet for each plug set.

Heavy mud from total depth to 600 feet - wood plug and 35 sacks by Halliburton at 600 feet. Heavy mud from top cement plug to 35 feet. Wood plug, 1/2 sack cottonseed hulls and 15 sacks cement from 35 feet to bottom cellar.

(If additional description is necessary, use BACK of this sheet)

Name of Plugging Contractor The R. W. Rine Drilling Company
Address 420 Union Center Building, Wichita 2, Kansas

STATE OF KANSAS COUNTY OF SEDGWICK, ss.
PAUL A. HARPER (employee of owner) or (owner or operator) of the above-described well, being first duly sworn on oath, says: That I have knowledge of the facts, statements, and matters herein contained and the log of the above-described well as filed and that the same are true and correct. So help me God.

(Signature) Paul A. Harper
The R. W. Rine Drilling Company
420 Union Center Bldg., Wichita 2, Kansas
(Address)

SUBSCRIBED AND SWORN to before me this 19th day of July, 19 57

Edna Landry
Notary Public.

My commission expires July 9, 1960

PLUGGING
FILE: SEC 26 T. 32 R. 30
BOOK PAGE 30 LINE 7

RECEIVED
STATE CORPORATE COMMISSION

COLLINGWOOD WELL NO. 1

JUL 20 1957

CONSERVATION DIVISION
Kansas

C SE SE
Sec. 26-32S-30W
Meade County, Kansas

CONTRACTOR: The R. W. Rine Drilling Co.

STARTED: June 20, 1957

COMPLETED: July 17, 1957

LOG

Sand & Shale	0	-	450	
Shale, Gyp & Red Bed	450	-	875	
Red Bed & Sand	875	-	1300	Syfo @ 960' 3/4° @ 1200' 3/4°
Sand & Gyp	1300	-	1370	
Shale, Gyp, Red Bed, Anhy.	1370	-	1545	Syfo @ 1420' 1/4°
Shale & Anhydrite	1545	-	1675	Set 8-5/8" @ 1603' w/ 800 sacks
Shale & Red Bed	1675	-	1860	
Red Bed & Shale	1860	-	2201	Syfo @ 2200' 3/4°
Shale & Lime	2201	-	2420	
Lime & Shale	2420	-	2585	
Lime w/ Shale Streaks	2585	-	2685	
Lime, Shale & Chert	2685	-	2752	Syfo @ 2750' 3/4°
Shale & Lime	2752	-	2886	
Lime & Shale	2886	-	3530	Syfo @ 3150' 3/4°
Lime, Shale & Chert	3530	-	3550	
Lime & Shale	3550	-	4382	Syfo @ 4255' 2°
Shale & Lime	4382	-	4472	
Lime & Shale	4472	-	4530	Syfo @ 4510' 3/4°
Lime	4530	-	4537	
Lime & Shale	4537	-	4570	
Lime w/ Shale Streaks	4570	-	4625	Syfo @ 4620' 1 1/2°
Lime & Shale	4625	-	4710	
Chalky Lime & Shale	4710	-	4750	Syfo @ 4750' 1-3/4°
Lime & Shale	4750	-	4857	Syfo @ 4850' 2°
Lime	4857	-	4949	Syfo @ 4945' 2°
Lime & Shale	4949	-	4990	
Lime	4990	-	5085	Syfo @ 5080' 2 1/2°
Lime & Shale	5085	-	5405	Syfo @ 5175' 1-3/4° @ 5300' 1-3/4°
Lime	5405	-	5451	
Lime & Shale	5451	-	5520	Syfo @ 5490' 1°
Lime	5520	-	5566	
Lime & Shale	5566	-	5612	Syfo @ 5600' 1 1/4°
Lime	5612	-	5703	
Shale & Lime	5703	-	5782	Syfo @ 5780' 1 1/2°
Rotary Total Depth			5782	
Corrected Schlumberger T.D.			5779	

PLUGGING

FILE SEC. 26 T. 32 R. 30W
BOOK PAGE 30 LINE 7

COLLINGWOOD WELL NO.

RECEIVED
STATE CORPORATION COMMISSION

JUL 20 1957

CONSERVATION DIVISION
Page No. 2

C SE SE
Sec. 26-32S-30W
Meade County, Kansas

STATE OF KANSAS)
) SS
COUNTY OF SEDGWICK)

I, R. M. Green, do hereby certify that the above is a true and accurate log of the Collingwood Well No. 1, located C SE SE of Section 26-32S-30W, Meade County, Kansas.

R. M. Green
Ass't Secretary and Treasurer

Subscribed and sworn to before me this 19th day of July, 1957.

John E. [Signature]

My Commission Expires: 6/14/58

PLUGGING
FILE SEC 26T 32R 30W
BOOK PAGE 30 LINE 7