


WELL PLUGGING RECORD

Give All Information Completely
Make Required Affidavit
Mail or Deliver Report to:
Conservation Division
State Corporation Commission
211 No. Broadway
Wichita, Kansas

NORTH

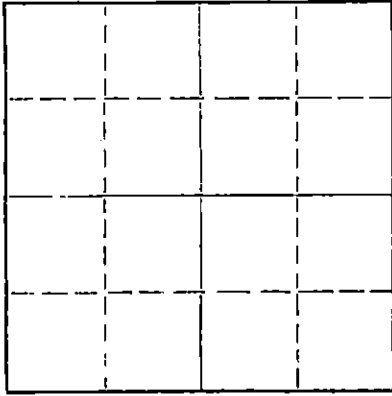

Locate well correctly on above
Section Plat

Meade County. Sec. 26 Twp. 32S Rge. (E) ³⁰ ~~20~~ (W)
Location as "NE/CNWxSWx" or footage from lines C NE NW
Lease Owner Leben Oil Corporation
Lease Name Bisbee Well No. #1
Office Address 200 W. Douglas Wichita, Kansas 67202
Character of Well (completed as Oil, Gas or Dry Hole) Dry Hole
Date well completed December 14, 1971
Application for plugging filed December 14, 1971
Application for plugging approved December 14, 1971
Plugging commenced December 14, 1971
Plugging completed December 14, 1971
Reason for abandonment of well or producing formation Dry Hole

If a producing well is abandoned, date of last production _____ 19____
Was permission obtained from the Conservation Division or its agents before plugging was commenced? Yes

Name of Conservation Agent who supervised plugging of this well Edgar Eves
Producing formation _____ Depth to top _____ Bottom _____ Total Depth of Well 6110 Feet
Show depth and thickness of all water, oil and gas formations.

OIL, GAS OR WATER RECORDS

CASING RECORD

FORMATION	CONTENT	FROM	TO	SIZE	PUT IN	PULLED OUT
				8 5/8"	1505'	-0-

Describe in detail the manner in which the well was plugged, indicating where the mud fluid was placed and the method or methods used in introducing it into the hole. If cement or other plugs were used, state the character of same and depth placed, from _____ feet to _____ feet for each plug set.

Plugged @ 1030' w/35 sx. common
Plugged @ 40' w/15sx.

RECEIVED
STATE CORPORATION COMMISSION
DEC 22 1971
CONSERVATION DIVISION
Wichita, Kansas

(If additional description is necessary, use BACK of this sheet)
Name of Plugging Contractor Leben Drilling, Inc.
Address 100 Park Ave. Building Oklahoma City, Oklahoma 73102

STATE OF _____, COUNTY OF _____, ss.
_____(employee of owner) or (owner or operator) of the above-described well, being first duly sworn on oath, says: That I have knowledge of the facts, statements, and matters herein contained and the log of the above-described well as filed and that the same are true and correct. So help me God.

(Signature) Leslie Kite

SUBSCRIBED AND SWORN TO before me this 21st day of December (Address) _____, 19 71


My commission expires 7-26-72 _____ Notary Public.



WELL LOG

Company Leben Oil Corporation
 Contractor Leben Drilling, Inc.
 Farm Bisbee #1
 Total Depth 6110'
 Commenced November 27, 1971
 Completed December 14, 1971

Sec. 26 T. 32S R. 30W
 Loc. C NE NW
 County Meade County
 Casing 8 5/8"
 Production

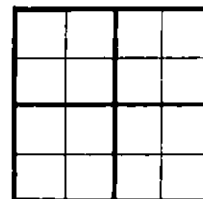

Figures Indicate Bottom of Formations

0'	-	121'	surface soil
121'	-	600'	sand - clay
600'	-	1347'	shale - anhy
1347'	-	1505'	shale & sand
1505'	-	1662'	shale & anhy
1662'	-	2142'	shale - shells
2142'	-	2496'	shale - shells - anhy
2496'	-	2668'	shale - anhy
2668'	-	2810'	shale - lime
2810'	-	3037'	dol.
3037'	-	3256'	lime - shale
3256'	-	3436'	lime - dol.
3436'	-	4932'	lime - shale
4932'	-	4993'	lime
4993'	-	5172'	lime - shale
5172'	-	5233'	lime
5233'	-	5268'	lime - shale
5268'	-	5312'	lime
5312'	-	5447'	lime - shale
5447'	-	5515'	lime
5515'	-	5655'	lime - shale
5655'	-	5661'	lime
5661'	-	5779'	lime - shale
5779'	-	5843'	lime
5843'	-	5980'	lime - shale
5980'	-	6040'	lime
6040'	-	6110'	lime - shale

RECEIVED
 STATE CORPORATION COMMISSION
 DEC 22 1971
 CONSERVATION DIVISION
 Wichita, Kansas

State of Oklahoma
 County of Oklahoma } SS

I, Leslie Kite of Leben Drilling, Inc., upon oath state that the above and foregoing is a true and correct copy of the log of the Bisbee #1 Well.

Leslie Kite

Subscribed and sworn to before me this 21st day of November, 1971

My Commission Expires: 7-26-72
[Signature]