

15-175-00022-0000

STATE OF KANSAS  
STATE CORPORATION COMMISSION

WELL PLUGGING RECORD

Give All Information Completely  
Make Required Affidavit  
Mail or Deliver Report to:  
Conservation Division  
State Corporation Commission  
800 Bittling Building  
Wichita, Kansas

Seward County. Sec. 17 Twp. 32S Rge. 11/31 (W)

Location as "NE/CNW%SW%" or footage from lines SW SE NE

Lease Owner Magnolia Petroleum Co.

Lease Name Mabel I. Hatcher Unit (PI) Well No. 1

Office Address Box 770, Great Bend, Kansas

Character of Well (completed as Oil, Gas or Dry Hole) Dry Hole

Date well completed 5 - 21 1958

Application for plugging filed 6 - 9 1958

Application for plugging approved Verbal 6 - 2 1958


Plugging commenced 6 - 2 1958

Plugging completed 6 - 3 1958

Reason for abandonment of well or producing formation Drilled Dry

If a producing well is abandoned, date of last production - 19-

Was permission obtained from the Conservation Division or its agents before plugging was commenced? Yes - verbal

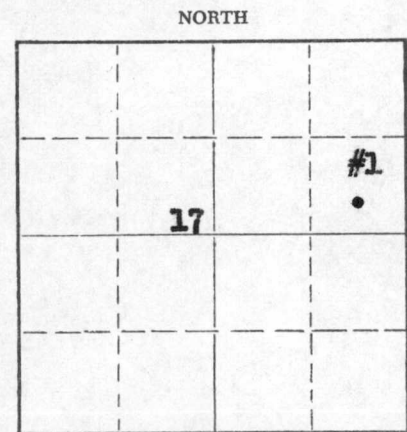

Locate well correctly on above Section Plat

Name of Conservation Agent who supervised plugging of this well Merle A. Rives

Producing formation Dry Hole Depth to top \_\_\_\_\_ Bottom \_\_\_\_\_ Total Depth of Well \_\_\_\_\_ Feet

Show depth and thickness of all water, oil and gas formations.

OIL, GAS OR WATER RECORDS

CASING RECORD

FORMATION	CONTENT	FROM	TO	SIZE	PUT IN	PULLED OUT
<u>Toronto</u>	<u>Dry</u>	<u>-</u>	<u>-</u>	<u>8-5/8</u>	<u>1508</u>	<u>None</u>

Describe in detail the manner in which the well was plugged, indicating where the mud fluid was placed and the method or methods used in introducing it into the hole. If cement or other plugs were used, state the character of same and depth placed, from \_\_\_\_\_ feet to \_\_\_\_\_ feet for each plug set.

TD 5781'. Mud fr 5781 to 550'. Pushed Halliburton plug to 550', 20 sx cmnt to 35', Halliburton plug to 35', 10 sx cmnt to base of cellar.

RECEIVED  
STATE CORPORATION COMMISSION

JUN 12 1958 6-12-58

CONSERVATION DIVISION  
Wichita, Kansas

(If additional description is necessary, use BACK of this sheet)

Name of Plugging Contractor Graham-Michaelis Drilling Co.

Address Wichita, Kansas

STATE OF Kansas, COUNTY OF Barton, ss. J. T. Rosenberger (employee of owner) or (owner/operator) of the above-described well, being first duly sworn on oath, says: That I have knowledge of the facts, statements, and matters herein contained and the log of the above-described well as filed and that the same are true and correct. So help me God.

(Signature) J. T. Rosenberger

Great Bend, Kansas  
(Address)

SUBSCRIBED AND SWORN TO before me this 10th day of June, 1958

Harriett S. Kaiser  
Notary Public.

My commission expires January 14, 1961

Orig: Corp. Comm.   
cc: Merle A. Rives  
File

PLUGGING  
FILE SEC. 17 T. 32 R. 31W  
BOOK PAGE 106 LINE 17

WELL LOG BUREAU—KANSAS GEOLOGICAL SOCIETY  
508 East Murdock, Wichita, Kansas


COPY

Company- **MAGNOLIA PETROLEUM CO.**  
Farm- **Mabel I. Hatcher No. 1**  
Unit

SEC. **17 T. 32 R.31W**  
SW SE NE

Total Depth. **5781'**  
Comm. **5-8-58** Comp. **6-3-58**  
Shot or Treated.  
Contractor. **Graham-Michaelis Drlg.**  
Issued. **7-12-58**

County **Seward**  
**KANSAS**

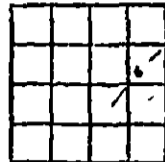

CASING:  
8 5/8" 1508' cem w/800 sx.

Elevation. 2798'

Production. **Dry**

Figures Indicate Bottom of Formations.

surface clay & sand	125
sand	423
sand - red bed	785
sand - red bed - shells	1058
shale & sand	1310
shale & anhydrite	1509
shale	1657
shale w/sand	2135
shale & lime	2388
lime & shale	2867
lime	3147
lime w/shale	3320
lime	3610
lime & shale w/chalk	3772
lime	3832
lime & shale	5661
lime	5741
lime	5781 RTD
Total Depth	

TOPS: SCOUT	
Herington	2638
Heebner	4235
Toronto	4277
Lansing	4377
Marmaton	5018
Cherokee	5186
Morrow	5494
Morrow Sand	5510
Chester	5574
St. Genevieve	5732