

STATE OF KANSAS
STATE CORPORATION COMMISSION


WELL PLUGGING RECORD

Give All Information Completely
Make Required ~~Plat~~
Mail or Deliver Report to:
Conservation Division
State Corporation Commission
800 Bitting Building
Wichita, Kansas

Seward County, Sec. 16 Twp. 32 Rge. (E) 31 (W)

Location as "NE/CNW&SW" or footage from lines SE NE NE
Lease Owner Colorado Oil & Gas Corporation
Lease Name Collins Well No. 1
Office Address Box 158, Liberal, Kansas
Character of Well (completed as Oil, Gas or Dry Hole) Gas
Date well completed 11-9-64 19
Application for plugging filed 11-12-64 19
Application for plugging approved 11-13-64 19
Plugging commenced 11-16-64 19
Plugging completed 11-23-64 19
Reason for abandonment of well or producing formation non commercial

NORTH

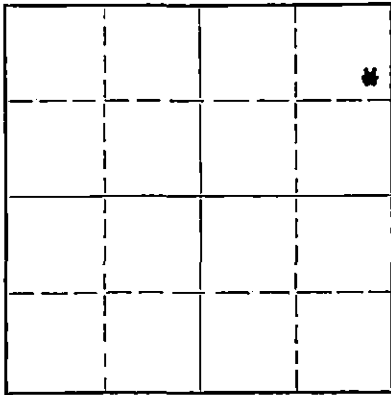

Locate well correctly on above
Section Plat

If a producing well is abandoned, date of last production September 19 64
Was permission obtained from the Conservation Division or its agents before plugging was commenced? Yes

Name of Conservation Agent who supervised plugging of this well Hugh Scott
Producing formation Miss. Depth to top Bottom Total Depth of Well 5750 Feet
Show depth and thickness of all water, oil and gas formations.

OIL, GAS OR WATER RECORDS

CASING RECORD

FORMATION	CONTENT	FROM	TO	SIZE	PUT IN	PULLED OUT
Miss.	Gas	5600	5600	8-5/8	1400	none
"	"	5608	5611	5-1/2	5749	2873
"	"	5611	5614			

Describe in detail the manner in which the well was plugged, indicating where the mud fluid was placed and the method or methods used in introducing it into the hole. If cement or other plugs were used, state the character of same and depth placed, from feet to feet for each plug set.

Pumped 20 sack cement plug to 3350'. Ran 35 sacks cement for plug at 700'.
Filled hole with mud and ran 15 sack cement plug five feet below ground level, welded cap on surface casing at this point.

RECEIVED
STATE CORPORATION COMMISSION

DEC 14 1964

CONSERVATION DIVISION
Wichita, Kansas

(If additional description is necessary, use BACK of this sheet)

Name of Plugging Contractor Gayle F. Toland
Address Box 4336 Oklahoma City, Oklahoma

STATE OF Kansas, COUNTY OF Seward, ss.
L. H. Walters (employee of owner) or (owner or operator) of the above-described well, being first duly sworn on oath, says: That I have knowledge of the facts, statements, and matters herein contained and the log of the above-described well as filed and that the same are true and correct. So help me God.


(Signature) *L. H. Walters*

(Address)

SUBSCRIBED AND SWORN TO before me this 11th day of December, 19 64

William B. Claunch
Notary Public.

My commission expires 11-1-66

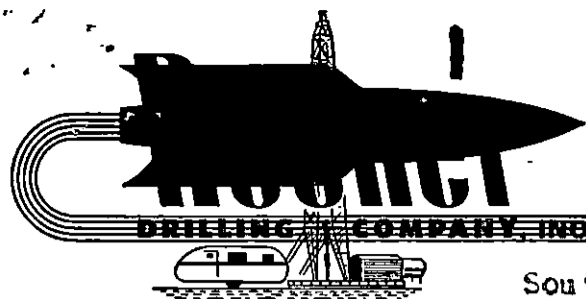

DRILLING COMPANY, INC. • P.O. Box 31279 • 352 N. BROADWAY • WICHITA, KANSAS

Southwestern Exploration - Vickers Petroleum
#1 Collins
C SW/4 NE/4 NE/4 Section 16-32S-31W
Seward County, Kansas

Southwestern Exploration Company
352 North Broadway
Wichita, Kansas

and

Vickers Petroleum Company, Inc.
Union Center Building
Wichita, Kansas

RECEIVED
STATE CORPORATION COMMISSION

NOV 13 1964

CONSERVATION DIVISION
Wichita, Kansas

Elevation: 2820 R.B.
Spudded: September 25, 1956
Rotary Completed: October 26, 1956
Contractor: Rocket Drilling Company, Inc.

CASING RECORD

1400' 8-5/8" O.D. 24# seamless casing cemented with 750 sacks cement.
574.9' 5-1/2" O.D. 14# seamless casing cemented with 200 sacks cement.

DRILLERS LOG

Clay & Sand	0 to 100	Lime & Shale	3433
Sand	200	Shale & Lime	3496
Sand & Shells	400	Lime	3624
Red Shale	500	Shale & Lime	3708
Red Bed	555	Lime & Shale	3848
Red Bed, Shale & Shells	770	Lime	3954
Sand Streaks & Shale	795	Lime & Shale	3995
Shale	870	Shale & Lime	4053
Sand	885	Lime	4138
Shale, Sand & Lime Streaks	990	Shale & Lime	4282
Shale & Lime Streaks	1090	Lime & Shale	4340
Anhydrite	1130	Lime	4584
Sand & Shale	1140	Shale & Lime	4707
Shale	1150	Lime	4751
Sand	1280	Shale & Lime	4857
Shale & Shells	1400	Lime	4908
Red Bed, Shale & Shells	1675	Shale & Lime	5011
Shale & Shells	2190	Lime & Shale	5070
Shale, Lime & Shells	2405	Lime	5241
Shale & Lime	2505	Shale & Lime	5296
Lime & Shale	2575	Lime & Shale	5358
Lime	2770	Shale & Lime	5432
Shale & Lime	2864	Lime	5470
Shale	2943	Shale & Lime	5596
Lime & Shale	2990	Lime & Iron	5600
Shale & Lime	3070	Lime	5651
Lime & Shale	3212	Shale & Lime	5750 T.D.
Shale & Lime	3282		

STATE OF KANSAS)
) SS
COUNTY OF SEDGWICK)

I hereby certify that to the best of my knowledge and belief the foregoing log is true and correct.

ROCKET DRILLING COMPANY, INC.

L. H. Myrick
L. H. Myrick

Subscribed and sworn to before me, a Notary Public, in and for the County and State aforesaid, this 30 day of October, 1956.
My commission expires:

10/28/1959

Deanne Helmer Spence
Notary Public