


STATE OF KANSAS
STATE CORPORATION COMMISSION

Form CP-4

Give All Information Completely
Make Required Affidavit
Mail or Deliver Report to:
Conservation Division
State Corporation Commission
P. O. Box 17027
Wichita, Kansas 67217
NORTH

WELL PLUGGING RECORD

Seward County. Sec. 14 Twp. 32S Rge. (E) 31 (W)
Location as "NE/CNW/SW" or footage from lines C SE/4 or 1320' FS & EL
Lease Owner CIG Exploration, Inc.
Lease Name Wanda Well No. 1
Office Address 415 W. 8th St.-Suite 300, Amarillo, Texas 79101
Character of Well (completed as Oil, Gas or Dry Hole) Dry Hole
Date well completed 11/20 1974
Application for plugging filed 11/20 1974
Application for plugging approved 11/20 1974
Plugging commenced 11/20 1974
Plugging completed 11/20 1974
Reason for abandonment of well or producing formation Dry Hole

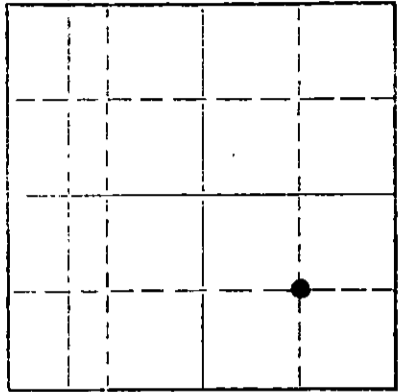

Locate well correctly on above Section Flat

If a producing well is abandoned, date of last production 19
Was permission obtained from the Conservation Division or its agents before plugging was commenced? Yes

Name of Conservation Agent who supervised plugging of this well Clarence Thomas
Producing formation None Depth to top Bottom Total Depth of Well 6195 Feet
Show depth and thickness of all water, oil and gas formations.

OIL, GAS OR WATER RECORDS

CASING RECORD

FORMATION	CONTENT	FROM	TO	SIZE	PUT IN	PULLED OUT
Krider	Salt water	2733	3016	8-5/8	1488	0
Council Grove	"	3016	4168			
Topeka	"	4168	4320			
Lansing	"	4432	5052			
Marmation	"	5052	5544			
Morrow	Gas	5544	5576			
St. Genevieve	Salt water	5576	5753			
St. Louis	"	5849				

Describe in detail the manner in which the well was plugged, indicating where the mud fluid was placed and the method or methods used in introducing it into the hole. If cement or other plugs were used, state the character of same and depth placed, from feet to feet for each plug set.

Spotted 80 sx cmt through drill pipe from 1478' to 1250'. Displaced with mud. Spotted 15 sx cmt from 45' to 0' through drill pipe

RECEIVED
STATE CORPORATION COMMISSION
DEC 9 1974
CONSERVATION DIVISION
Wichita, Kansas

(If additional description is necessary, use BACK of this sheet)

Name of Plugging Contractor Service Drilling Company
Address Tulsa, Oklahoma

STATE OF TEXAS COUNTY OF POTTER, ss.
J. D. Stewart, Jr. (employee of owner) or (owner or operator) of the above-described well, being first duly sworn on oath, says: That I have knowledge of the facts, statements, and matters herein contained and the log of the above-described well as filed and that the same are true and correct. So help me God.

(Signature) J. D. Stewart, Jr.
415 W. 8th St.-Suite 300, Amarillo, Texas 79101
(Address)

SUBSCRIBED AND SWORN to before me this 4th day of December, 19 74

My commission expires June 1, 1975

Patricia Mann
Notary Public.