


WELL PLUGGING RECORD

Give All Information Completely
Make Required Affidavit
Mail or Deliver Report to:
Conservation Division
State Corporation Commission
211 No. Broadway
Wichita, Kansas

NORTH

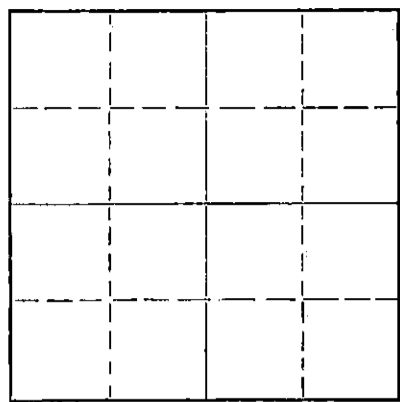

Locate well correctly on above Section Plat

Seward County. Sec. 13 Twp. 32 Rge. (E) 31 (W)
Location as "NE/CNW/SW" or footage from lines C S/2 SE NE
Lease Owner Earl F. Wakefield & Etal
Lease Name Richardson Well No. 1
Office Address 515 Union Center Building
Character of Well (completed as Oil, Gas or Dry Hole) Dry Hole
Date well completed December 19 19 56
Application for plugging filed December 19 19 56
Application for plugging approved December 19 19 56
Plugging commenced December 19 19 56
Plugging completed December 19 19 56
Reason for abandonment of well or producing formation _____

If a producing well is abandoned, date of last production _____ 19____
Was permission obtained from the Conservation Division or its agents before plugging was commenced? Yes

Name of Conservation Agent who supervised plugging of this well M. A. Rives
Producing formation _____ Depth to top _____ Bottom _____ Total Depth of Well 5758 Feet
Show depth and thickness of all water, oil and gas formations.

OIL, GAS OR WATER RECORDS

CASING RECORD

FORMATION	CONTENT	FROM	TO	SIZE	PUT IN	PULLED OUT
				8 5/8"	1594'	None

Describe in detail the manner in which the well was plugged, indicating where the mud fluid was placed and the method or methods used in introducing it into the hole. If cement or other plugs were used, state the character of same and depth placed, from _____ feet to _____ feet for each plug set.

Hole filled with Drilling mud to 730'
Howco plug set w/35 sacks cement, filled
w/mud to 30ft; 10 sacks cement to surface

(If additional description is necessary, use BACK of this sheet)
Name of Plugging Contractor Earl F. Wakefield
Address 515 Union Center Building, Wichita, Kansas

STATE OF KANSAS, COUNTY OF SEDGWICK, ss.
Earl F. Wakefield (~~WIDOW OF~~) or (owner or operator) of the above-described well, being first duly sworn on oath, says: That I have knowledge of the facts, statements, and matters herein contained and the log of the above-described well as filed and that the same are true and correct. So help me God.

(Signature) Earl F. Wakefield
515 Union Center Building
(Address)

SUBSCRIBED AND SWORN to before me this 20th day of December, 19 56

My commission expires July 26, 1958

[Signature]
Notary Public.

RECEIVED
C. A. STATE CORPORATION COMMISSION
1-2-57

PLUGGING
FILE SEC. 13 T. 32 R. 31W
BOOK PAGE 126 LINE 39

CONSERVATION DIVISION
Wichita, Kansas

LEASE: Richardson #1
 OPERATOR: Earl F. Wakefield
 CONTRACTOR: Earl F. Wakefield
 COMM: 11-21-56 COMP: 12-19-56

LOCATION: C S/2 SE NE 13-32-31
 Seward County, Kansas
 CASING: 8 5/8" Set @ 1594'

Elevation: 2784' D.F.
 2786' K.B.

Soil & Sandy Clay	159	Lime	4794
Clay, Sand & Gravel	350	Lime, Shale Stks	4832
Clay & Gravel	524	Lime & Shale	4939
Red Shale	837	Lime	4994
Red Bed, Shells & Anhydrite	1045	Lime & Shale	5500
Red Shale, Lime & Shells	1150	Lime	5532
Shale	1280	Lime & Shale	5558
Shale & Shells	1385	Core #1	5592
Lime & Shale	1405	Shale & Lime	5758
Red Bed, Stks Lime, Chert & Dolomite	1525	T.R.D.	5758
Shale & Lime Stks	1594		
Red Bed	1634		
Red Shale	1660		
Sand	1713		
Lime	1734		
Shale	2232		
Anhydrite W/Stks Salt	2444		
Sandy Lime & Shale	2627		
Shale & Lime	2705		
Lime	2735		
Lime & Shale	2738		
Lime, Cherty & Shale	2830		
Lime & Shale	3268		
Lime, Shale, Chalk Stks	3331		
Lime & Shale	3787		
Chalky Lime	3835		
Lime	3870		
Chalky Lime	3903		
Lime & Shale	4045		
Hard Lime	4197		
Lime & Chalky Lime	4348		
Lime & Shale	4400		
Chalky Lime	4493		
Lime	4505		
Lime & Shale	4643		
Chalky Lime	4669		

STATE OF KANSAS)
) SS
 COUNTY OF SEDGWICK)

I hereby certify that the above is a true and correct copy of the log of the Richardson #1 well located C S/2 SE NE 13-32-31, Seward County, Kansas

Earl F. Wakefield

Subscribed and sworn to before me this 28th day of December 1956

[Signature]

My Commission Expires: 7-26-58

RECEIVED
 SURVEYOR'S COMMISSION

PLUGGING
 FILE SEC. 13 T. 32 R. 31W
 BOOK PAGE 126 LINE 39

CONSERVATION DIVISION
 Wichita, Kansas