


STATE OF KANSAS CORPORATION COMMISSION

All Information Completely Make Required Affidavit Mail or Deliver Report to: Conservation Division State Corporation Commission P. O. Box 17027 Wichita, Kansas 67217 NORTH

WELL PLUGGING RECORD

Seward County, Sec. 12 Twp. 32S Rge. 31W (W)

Location as "NE/CNW/SE" or footage from lines C SE SE Lease Owner: Texas Energies, Inc. Lease Name: Williamson Well No. 1 Office Address: 306 Bank of the Southwest, Amarillo, TX 79109 Character of Well (completed as Oil, Gas or Dry Hole) oil and gas Date well completed October 19 56 Application for plugging filed January 4 19 74 Application for plugging approved January 10 19 74 Plugging commenced January 12 19 74 Plugging completed January 15 19 74 Reason for abandonment of well or producing formation Uneconomical to produce

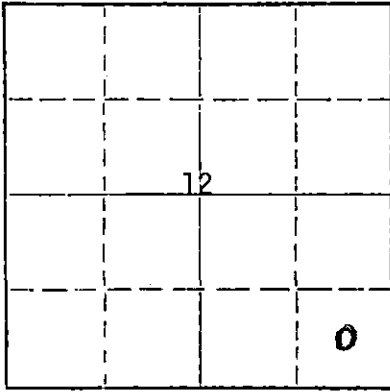

Locate well correctly on above Section Plat

If a producing well is abandoned, date of last production August 19 73 Was permission obtained from the Conservation Division or its agents before plugging was commenced? yes

Name of Conservation Agent who supervised plugging of this well Edgar Eves Producing formation Upper Morrow Depth to top 5502 Bottom 5512 Total Depth of Well 5673 Feet Show depth and thickness of all water, oil and gas formations.

OIL, GAS OR WATER RECORDS

CASING RECORD

Table with columns: FORMATION, CONTENT, FROM, TO, SIZE, PUT IN, PULLED OUT. Rows include Chester, Morrow, Marmaton, Kansas City, 8 5/8" surface casing, and 5 1/2" production casing.

Describe in detail the manner in which the well was plugged, indicating where the mud fluid was placed and the method or methods used in introducing it into the hole. If cement or other plugs were used, state the character of same and depth placed, from feet to feet for each plug set.

Pumped 1 sack Hulls and 20 sacks portland cement to plug off perforations @ 5502', stopped plug @ 5400'.

Pumped 50 sacks portland cement from 900' to 800', displaced with 3 sacks fresh gel.

Filled hole with mud to 33'. Put 15 sacks cement from 33 to 3 feet.

RECEIVED STATE CORPORATION COMMISSION MAR 1 1974 CONSERVATION DIVISION Wichita, Kansas

Name of Plugging Contractor Sargent's Casing Plugging Service (if additional description is necessary, use BACK of this sheet) Address Box 506, Liberal, Kansas

STATE OF TEXAS, COUNTY OF POTTER, ss. L. E. Geoffroy, Jr.

(employee of owner) or (owner or operator) of the above-described well, being first duly sworn on oath, says: That I have knowledge of the facts, statements, and matters herein contained and the log of the above-described well as filed and that the same are true and correct. So help me God.

(Signature)

306 Bank of the Southwest, Amarillo, TX 79109 (Address)

SUBSCRIBED AND SWORN TO before me this 27th day of February, 1974

My commission expires June 1, 1975

Betty Allston Cox Notary Public


WELL LOG BUREAU—KANSAS GEOLOGICAL SOCIETY
503 East Murdock, Wichita, Kansas

Company- EARL F. WAKEFIELD & ETAL
Farm: Williamson No. 1

SEC. 12 T. 32 R. 31W
C SE SE

Total Depth. 5673'
Comm. 9-12-56 Comp. 10-11-56
Shot or Treated.
Contractor. Earl F. Wakdfield
Issued. 12-15-56

County Seward
KANSAS

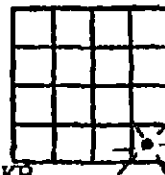

Elevation. 2779' KB

Production. 2,140,000 CFGPD

Figures indicate Bottom of Formations.

sdv clay	590
red bed-gyp	1050
lime-gyp	1084
shale-red bed-lime	1350
lime	1434
red bed-lime stks	1586
Anhydrite-red bed	1710
salt-Anhydrite	1820
shale-lime stks	2094
lime-shale	2170
Dolomite-chert	2280
lime	2430
lime w/cherty stks	2520
lime-chert	2663
lime	2764
lime-dolomite-shale	2845
dolomite-shale	2990
chalky lime	3050
lime	3095
lime w/chalk stringers	3163
lime w/chert stks	3170
lime	3175
chalky lime	3683
lime w/chalk stks	3748
chalky lime	3875
lime	4056
lime-shale	4175
lime	4212
lime-shale	4321
lime-shale stks	4396
lime-shale	4436
lime	4820
lime w/shale stks-chert	4853
lime-shale	4963
lime	4980
shale w/stks lime	5016
shale-lime	5066
lime w/shale stks	5119
lime-shale	5386
lime	5438
lime-shale stks	5472
lime-shale	5504
sand	5511
lime-shale	5600
lime	5617
lime-shale	5673
Total Depth	

TOPS: Scout	
Lansing	4435
Kansas City	4575
B/Kansas City	4980
Cherokee	5230
Morrow sand	5504
Morrow lime	5511
Mississippi	5573

RECEIVED
STATE CORPORATION COMMISSION
JAN 10 1974
CONSERVATION DIVISION
Wichita, Kansas