


STATE OF KANSAS
STATE CORPORATION COMMISSION

Give All Information Completely
Make Required Affidavit
Mail or Deliver Report to:
Conservation Division
State Corporation Commission
212 North Market, Insurance Bldg.
Wichita, Kansas

WELL PLUGGING RECORD

Seward County, Sec. 7 Twp. 32S Rge. (E) 31 (W)

Location as "NE/CNW/SW" or footage from lines C SE/4 NW/4
Lease Owner Skelly Oil Company
Lease Name M. M. Sutton Well No. 1
Office Address Box 1650, Tulsa, Oklahoma
Character of Well (completed as Oil, Gas or Dry Hole) Dry Hole
Date well completed February 7, 19 61
Application for plugging filed February 9, 19 61
Application for plugging approved February 13, 19 61
Plugging commenced February 8, 19 61
Plugging completed February 8, 19 61
Reason for abandonment of well or producing formation Dry hole

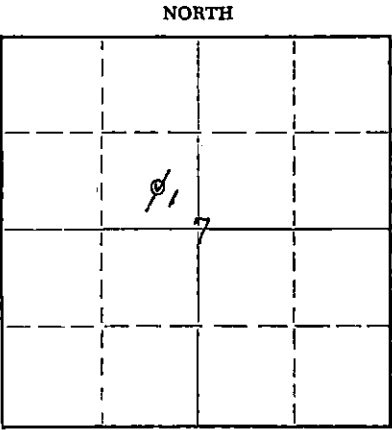

Locate well correctly on above Section Plat

If a producing well is abandoned, date of last production 19

Was permission obtained from the Conservation Division or its agents before plugging was commenced? Yes (verbally)

Name of Conservation Agent who supervised plugging of this well Mr. W. L. Lackamp

Producing formation None Depth to top Bottom Total Depth of Well 5937 Feet

Show depth and thickness of all water, oil and gas formations.

OIL, GAS OR WATER RECORDS

CASING RECORD

FORMATION	CONTENT	FROM	TO	SIZE	PUT IN	PULLED OUT
St. Louis	Dry	5794'	5937'	8-5/8"	1678'1"	None

Describe in detail the manner in which the well was plugged, indicating where the mud fluid was placed and the method or methods used in introducing it into the hole. If cement or other plugs were used, state the character of same and depth placed, from feet to feet for each plug set.

Mud	5937' to 5840'
100 sacks of cement	5840' to 5492'
Mud	5492' to 600'
Rock bridge	600' to 590'
35 sacks of cement	590' to 485'
Mud	485' to 35'
Rock bridge	35' to 25'
12 sacks of cement	25' to 6'
Surface soil	6' to Surface

RECEIVED
STATE CORPORATION COMMISSION
FEB 23 1961
CONSERVATION DIVISION
Wichita, Kansas

Name of Plugging Contractor Garvey Drilling Company
Address R.F.D. #2, Great Bend, Kansas

STATE OF Kansas, COUNTY OF Reno, ss.
H. E. Wamsley (employee of owner) or (owner or operator) of the above-described well, being first duly sworn on oath, says: That I have knowledge of the facts, statements, and matters herein contained and the log of the above-described well as filed and that the same are true and correct. So help me God.

(Signature) [Signature]
Box 391 Hutchinson, Kansas (Address)

SUBSCRIBED AND SWORN TO before me this 27th day of February, 19 61

My commission expires April 7, 1963 [Signature] Notary Public.