


WELL PLUGGING RECORD

Give All Information Completely
Make Required Affidavit
Mail or Deliver Report to:
Conservation Division
State Corporation Commission
211 No. Broadway
Wichita, Kansas

Seward County. Sec. 6 Twp. 32S Rge. 31W (E) (W)
SW NE

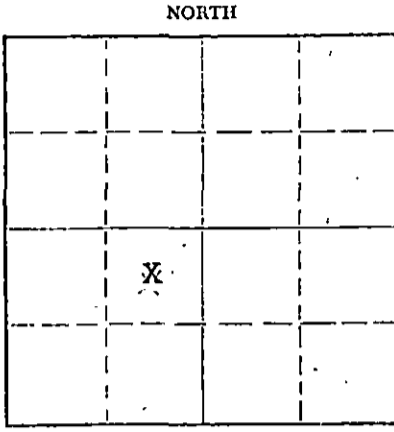

Location as "NE/CNW/SW" or footage from lines _____
Lease Owner W. M. Gruenerwald & Associates
Lease Name Woodworth Well No. 1
Office Address Box 909, Colorado Springs, Colorado 80900
Character of Well (completed as Oil, Gas or Dry Hole) Dry
Date well completed Shown on log 10-29-67 1967
Application for plugging filed 12-11 1971
Application for plugging approved 12-16 1971
Plugging commenced 12/28 1970
Plugging completed 12/30/ 1970
Reason for abandonment of well or producing formation Dry

Locate well correctly on above
Section Plat

If a producing well is abandoned, date of last production _____ 19____
Was permission obtained from the Conservation Division or its agents before plugging was commenced? yes

Name of Conservation Agent who supervised plugging of this well Mr. Ed Eves
Producing formation _____ Depth to top _____ Bottom _____ Total Depth of Well 5975 Feet
Show depth and thickness of all water, oil and gas formations.

OIL, GAS OR WATER RECORDS

CASING RECORD

FORMATION	CONTENT	FROM	TO	SIZE	PUT IN	PULLED OUT
<u>Log mailed in with plugging application</u>				<u>2 7/8"</u>	<u>5975 ft.</u>	<u>2795.72 ft.</u>

Describe in detail the manner in which the well was plugged, indicating where the mud fluid was placed and the method or methods used in introducing it into the hole. If cement or other plugs were used, state the character of same and depth placed, from _____ feet to _____ feet for each plug set.

Mix 1 sk. hulls and 8 sks. cement to plug off perfs at 4,900'.
Stop plug at 4,000'.
Pump 35 sks. cement at 900' to 800'.
Put 15 sks. cement at 45' to 0'.

RECEIVED
STATE CORPORATION COMMISSION
JAN 20 1971
CONSERVATION DIVISION
Wichita, Kansas

(If additional description is necessary, use BACK of this sheet)
Name of Plugging Contractor Sargent's Casing Pulling Service
Address Box 506, Liberal, Kansas 67901

STATE OF Kansas COUNTY OF Seward ss.
Ed Eves (employee of owner) or (owner or operator) of the above-described well, being first duly sworn on oath, says: That I have knowledge of the facts, statements, and matters herein contained and the log of the above-described well as filed and that the same are true and correct. So help me God. SARGENTS CASING PULLING SERVICE
(Signature) Robert A. Trilling, Partner
P.O. Box 506, Liberal, Kansas 67901
(Address)

SUBSCRIBED AND SWORN TO before me this 8th day of January 19 71

My commission expires _____

MONA M. CLARK
NOTARY PUBLIC
Seward County, Kansas
My Commission Expires
Sept. 15, 1974

Mona M. Clark
Notary Public.