


STATE OF KANSAS
STATE CORPORATION COMMISSION

WELL PLUGGING RECORD

Give All Information Completely
Make Required Affidavit
Mail or Deliver Report to:
Conservation Division
State Corporation Commission
211 No. Broadway
Wichita, Kansas

Seward County. Sec. 29 Twp. 32S Rge. (E) 31 (W)
Location as "NE/CNW/SW" or footage from lines C-NW-SE
Lease Owner J. M. Huber Corporation
Lease Name Reiss Well No. 1
Office Address Box 978 Liberal, Kansas
Character of Well (completed as Oil, Gas or Dry Hole) Dry hole
Date well completed August 5 19 62
Application for plugging filed August 30 19 62
Application for plugging approved August 30 19 62
Plugging commenced August 30 19 62
Plugging completed August 31 11:30 A.M. 19 62
Reason for abandonment of well or producing formation Dry hole

NORTH

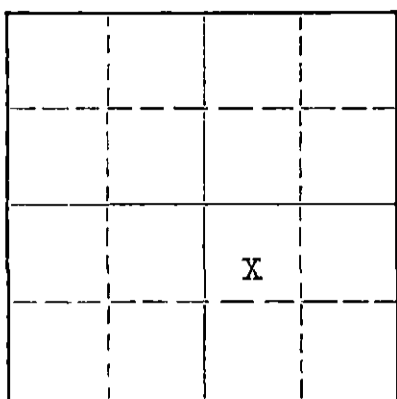

Locate well correctly on above
Section Plat

If a producing well is abandoned, date of last production None 19
Was permission obtained from the Conservation Division or its agents before plugging was commenced? yes

Name of Conservation Agent who supervised plugging of this well Mr. Hugh Scott
Producing formation None Depth to top _____ Bottom _____ Total Depth of Well 6000 Feet
Show depth and thickness of all water, oil and gas formations.

OIL, GAS OR WATER RECORDS

CASING RECORD

FORMATION	CONTENT	FROM	TO	SIZE	PUT IN	PULLED OUT
				8-5/8	2599	-
				4-1/2	6000	1642

Describe in detail the manner in which the well was plugged, indicating where the mud fluid was placed and the method or methods used in introducing it into the hole. If cement or other plugs were used, state the character of same and depth placed, from _____ feet to _____ feet for each plug set.

Put 10 sx cement at 5121' to 5091'
Filled w/mud to 700'
Put 35 sx cement plug from 700' to 595'
Filled w/mud to 45'
Put 15 sx plug from 45' to surface
Cut 4-1/2" csg. and pulled 1642'

RECEIVED
STATE CORPORATION COMMISSION

SEP 6 1962

CONSERVATION DIVISION
Wichita, Kansas

(If additional description is necessary, use BACK of this sheet)

Name of Plugging Contractor Daco Well Service
Address Borger, Texas

STATE OF Kansas, COUNTY OF Seward, ss.
Floyd L. Meade (employee of owner) or (owner or operator) of the above-described well, being first duly sworn on oath, says: That I have knowledge of the facts, statements, and matters herein contained and the log of the above-described well as filed and that the same are true and correct. So help me God.

(Signature) Floyd L. Meade
Box 978 Liberal, Kansas
(Address)

SUBSCRIBED AND SWORN TO before me this 5th day of Sept, 1962
Floyd L. Meade
Notary Public.

My commission expires MY COMMISSION EXPIRES OCT. 27, 1962

DRILLERS LOG

RECEIVED
STATE CORPORATION COMMISSION

SEP 18 1962

CONSERVATION DIVISION
Wichita, Kansas

Operator: J. M. Huber Corporation
2401 East Second Ave.
Denver, Colorado

Elevation:

Date Commenced: June 29, 1962

Contractor: Midwestern Drillers, Inc.
1206 Mid-Continent Bldg
Tulsa 3, Oklahoma

Date Completed: July 18, 1962

Total Depth: 6000' RB

Lease Name: Reiss No. 1

Lease Location: Center of NW, SE, Sec. 29,
T 32S, R 31W, Seward County,
Kansas

Casing Record: Surface - Set 2599' of 8 5/8" casing
with 300 sacks of Pozmix
plus 2% cc through bottom
and with 275 sacks of Pozmix
plus 2% cc through DV tool
set at 724'. Cemented with
40 sacks of cement from top
through 1" pipe.

Production - Set 6000' of 4 1/2" casing
with 200 sacks of salt saturated
common cement.

Formation	Depth from Rotary Bushing
	0
Surface sand and clay	.70
Sand and red bed	630
Red bed and gypsum	1295
Red bed and gypsum	1780
Red bed and anhydrite	1905
Anhydrite and shale	2190
Anhydrite and shale	2400
Anhydrite and shale	2570
Lime and shale	2600 Ran 2599' of 8 5/8" casing
Lime and shale	3000
Lime and anhydrite	3200
Lime and gypsum	3370
Lime and gypsum	3501
Lime and shale	3760
Lime and chalk	4155
Lime and shale	4290
Lime and shale	4445
Lime	4630
Lime	4864
Lime and shale	5160
Lime and shale	5400
Lime and shale	5618 Ran DST #1 at 5618'
Lime	5785
Lime and shale	5930
Lime	6000 TD Ran electric log at 6000' Ran 6000' of 4 1/2" casing Ran temperature survey

RECEIVED
STATE CORPORATION COMMISSION

SEP 18 1962

CONSERVATION DIVISION
Wichita, Kansas

I hereby certify that this is a true and correct copy of Drillers Log on the Reiss No. 1 well of J. M. Huber Corporation.

MIDWESTERN DRILLERS, INC.

By J. W. Bryant

Subscribed and sworn to before me this 24th day of July, 1962.

My Commission Expires:

February 6, 1966

Berbara Carley
Notary Public