

Give All Information Completely
Make Required Affidavit
Mail or Deliver Report to:
Conservation Division
State Corporation Commission
212 No. Market
Wichita, Kansas

WELL PLUGGING RECORD

Seward County, Sec. 27 Twp. 32S Rge. - (E) 31 (W)

Location as "NE/CNW/SW" or footage from lines Center SW NW

Lease Owner Yucca Petroleum Co.

Lease Name Tendick Well No. 1

Office Address P. O. Box 2585, Amarillo, Texas 79105

Character of Well (completed as Oil, Gas or Dry Hole) Dry Hole

Date well completed August 14 19 69

Application for plugging filed August 14 19 69

Application for plugging approved August 14 19 69


Plugging commenced August 14 19 69

Plugging completed August 14 19 69

Reason for abandonment of well or producing formation Dry Hole

If a producing well is abandoned, date of last production None 19

Was permission obtained from the Conservation Division or its agents before plugging was commenced? YES

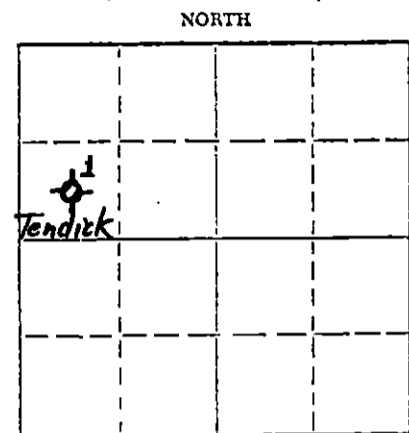

Locate well correctly on above Section Plat

Name of Conservation Agent who supervised plugging of this well Mr. Edgar Eves (Sublette, Kansas)

Producing formation None Depth to top - Bottom - Total Depth of Well 5989 Feet

Show depth and thickness of all water, oil and gas formations.

OIL, GAS OR WATER RECORDS

CASING RECORD

FORMATION	CONTENT	FROM	TO	SIZE	PUT IN	PULLED OUT
St. Louis (Miss.)	Salt Water	5945	5976	8-5/8"-24#	1878	None
(No commercial oil or gas zones encountered)						

RECEIVED
CORPORATION COMMISSION
AUG 18 1969
CONSERVATION DIVISION
Wichita, Kansas

Describe in detail the manner in which the well was plugged, indicating where the mud fluid was placed and the method or methods used in introducing it into the hole. If cement or other plugs were used, state the character of same and depth placed, from feet to feet for each plug set.

Using open ended drill pipe, Halliburton pump truck and Pozmix cement, spotted following cement plugs:

- 50 sacks 5782 - 5973' (in open 7-7/8" hole)
- 50 sacks 1455 - 1626' (across bottom 8-5/8" pipe)
- 15 sacks 0 - 25' (in top of 8-5/8" surface pipe)

Balance of hole has heavy drilling mud throughout.

(If additional description is necessary, use BACK of this sheet)

Name of Plugging Contractor Stickle Drilling Co. (Drilling Contractor)

Address 1100 Bitting Bldg., Wichita, Kansas 67202

STATE OF TEXAS, COUNTY OF Potter, ss.
V. E. LEWIS (employee of owner) or (owner or operator) of the above-described well, being first duly sworn on oath, says: That I have knowledge of the facts, statements, and matters herein contained and the log of the above-described well as filed and that the same are true and correct. So help me God.

(Signature) [Signature]

Box 2585, Amarillo, Texas 79105 (Address)

SUBSCRIBED AND SWORN TO before me this 15th day of August, 1969

[Signature] Lucille D. Cook Notary Public.

My commission expires 6-1-71

Yucca Petroleum Company
Amarillo, Texas 79105

Drlg. Contractor: Stickle Drilling Company
Date Commenced: 26 July 1969
Date Completed: 14 August 1969

Tendick No. 1
C SW NW 27-32S-31W
Seward County, Kansas

DRILLER'S LOG


Depth figures indicate base of formation:

Surface Soil and Clay	120
Sand and Clay	542
Red Bed and Shale	1315
Red Bed and Sand	1594
Anhydrite	1620
Anhydrite, Sand, Shale and Red Bed	1920
Shale and Anhydrite	2365
Anhydrite and Shale	2570
Lime	3577
Lime and Shale	3804
Lime	4108
Shale and Lime	4208
Lime and Shale	4309
Lime	5467
Lime and Shale	5605
Shale and Lime	5675
Lime	5986 RTD

RECEIVED
STATE CORPORATION COMMISSION
AUG 20 1969
CONSERVATION DIVISION
Wichita, Kansas

I, R. B. Parriott, hereby certify that to the best of my knowledge and belief, the above is a true and complete Driller's Log of Yucca Petroleum Company's Tendick No. 1 in Seward County, Kansas.

R. B. Parriott
R. B. Parriott

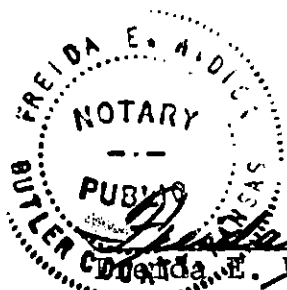

Freida E. Widick
Freida E. Widick, Notary Public
My Commission Expires 23 June 1970