

15-175-20512-0000


STATE OF KANSAS  
STATE CORPORATION COMMISSION  
CONSERVATION DIVISION  
P. O. BOX 17027  
WICHITA, KANSAS 67317

WELL PLUGGING RECORD

IREX Corp Permit to Plug # 6083

Seward County, Sec. 26 Twp. 32S Rge. (E) 31 (W)

R31W  
NORTH

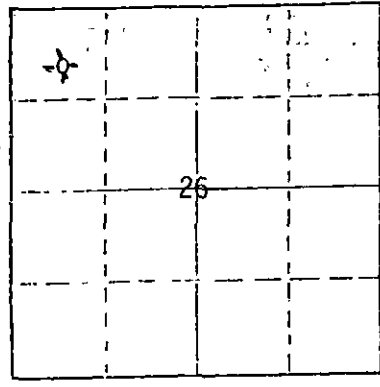

Locate well correctly on above Section Plat

Location as "NE/CNWSW" or footage from lines: CNWNW  
Lease Owner: Irex Corporation  
Lease Name: Hawk Well No. 1  
Office Address: P.O. Box 508 Protection, KS 67127  
Character of Well (completed as Oil, Gas or Dry Hole): Oil  
Date well completed: 3/28/81 1981  
Application for plugging filed: July 25, 1983  
Application for plugging approved: August 1, 1983  
Plugging commenced: 4:00 p.m. August 2, 1983  
Plugging completed: 12:00 noon, August 6, 1983  
Reason for abandonment of well or producing formation: Depleted

If a producing well is abandoned, date of last production: 11/20/81 1981  
Was permission obtained from the Conservation Division or its agents before plugging was commenced? Yes

Name of Conservation Agent who supervised plugging of this well: Benny Beck  
Producing formation: MORROW Depth to top: 5495 Bottom: 5552 Total Depth of Well: 6020 Feet  
Show depth and thickness of all water, oil and gas formations.

OIL, GAS OR WATER RECORDS

CASING RECORD

FORMATION	CONTENT	FROM	TO	SIZE	PUT IN	PULLED OUT
				4 1/2"	6020'	3222.92'
				8 5/8"	1600'	None

Describe in detail the manner in which the well was plugged, indicating where the mud fluid was placed and the method or methods used in introducing it into the hole. If cement or other plugs were used, state the character of same and depth placed, from \_\_\_\_\_ feet to \_\_\_\_\_ feet for each plug set.

- 8-3-83 Set CIBP @ 5500' + 2 sacks cement on top.
- 8-4-83 Shot and started pipe @ 3212', pulled 1' joint.
- 8-5-83 Pulled 36 joints of casing. Pumped 50 sacks cement from 1650-1550'. Pulled 19 joints. Pumped 40 sacks cement to 810'. Pulled 21 joints. Capped surface with 10 sacks cement from 3-40'.
- 8-6-83 Cut off well head, welded on steel plate, moved off location.

(If additional description is necessary, use BACK of this sheet)

Name of Plugging Contractor: Reeves & Wilson, Inc.  
Address: P.O. Box 963 Woodward, Oklahoma 73802

STATE OF Colorado COUNTY OF Denver ss.  
W. H. Bayliff (employee of owner) or (XXXXXX) of the above-described

well, being first duly sworn on oath, says: That I have knowledge of the facts, statements, and matters herein contained and the log of the above-described well as filed and that the same are true and correct. So help me God.

(Signature) W.H. Bayliff, Operations Manager IREX Corp.  
1670 Broadway, Suite 2301  
Denver, Colorado 80202

SUBSCRIBED AND SWORN TO before me this 19th day of September 1983

My commission expires June 9, 1985  
Mary J. Warren Notary Public

SEP 21 1983  
CONSERVATION DIVISION  
Wichita, Kansas