


STATE OF KANSAS  
STATE CORPORATION COMMISSION

Give All Information Completely  
Make Required Affidavit  
Mail or Deliver Report to:  
Conservation Division  
State Corporation Commission  
211 No. Broadway  
Wichita, Kansas

WELL PLUGGING RECORD

Seward County, Sec. 26 Twp. 32S Rge. 31W (E) (W)  
Location as "NE/CNW&SW" or footage from lines: C SW SW  
Lease Owner White Shield Oil & Gas Corp.  
Lease Name Wills Well No. 1  
Office Address P. O. 2139, Tulsa, Oklahoma 74101  
Character of Well (completed as Oil, Gas or Dry Hole) Dry Hole  
Date well completed 5-16-69 19  
Application for plugging filed 5-16-69 19  
Application for plugging approved 5-18-69 19  
Plugging commenced 5-18-69 19  
Plugging completed 5-18-69 19  
Reason for abandonment of well or producing formation Dry Hole

NORTH

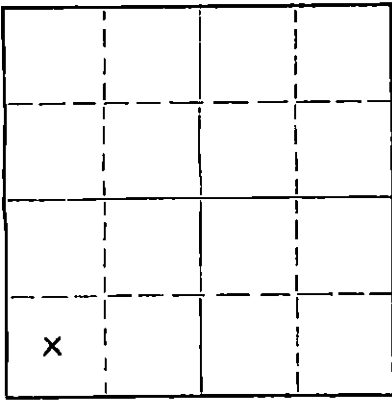

Locate well correctly on above Section Plat

If a producing well is abandoned, date of last production None 19  
Was permission obtained from the Conservation Division or its agents before plugging was commenced? Yes

Name of Conservation Agent who supervised plugging of this well E. Eves Box "F" Sublette, Kansas  
Producing formation - Depth to top - Bottom - Total Depth of Well 6010 Feet  
Show depth and thickness of all water, oil and gas formations.

OIL, GAS OR WATER RECORDS

CASING RECORD

FORMATION	CONTENT	FROM	TO	SIZE	PUT IN	PULLED OUT
				8 5/8"	1569'	

Describe in detail the manner in which the well was plugged, indicating where the mud fluid was placed and the method or methods used in introducing it into the hole. If cement or other plugs were used, state the character of same and depth placed, from \_\_\_\_\_ feet to \_\_\_\_\_ feet for each plug set.

Plugged @ 5:30 A.M. 5-18-69, W/35 sxs. cement 800' to 900' and 45' to Surface.  
Witnessed by Corporation Commission representative and approved, P&A

RECEIVED  
STATE CORPORATION COMMISSION  
JUN 2 1969  
CONSERVATION DIVISION  
Wichita, Kansas

(If additional description is necessary, use BACK of this sheet)

Name of Plugging Contractor Service Drilling Company  
Address Beacon Building, Tulsa, Oklahoma

STATE OF OKLAHOMA, COUNTY OF TULSA, ss.  
J. D. VanHorn (employee of owner) or (owner or operator) of the above-described well, being first duly sworn on oath, says: That I have knowledge of the facts, statements, and matters herein contained and the log of the above-described well as filed and that the same are true and correct. So help me God.

(Signature) J. D. VanHorn  
P.O. Box 2139, Tulsa Okla. 74101  
(Address)

SUBSCRIBED AND SWORN to before me this 28th day of May, 19 69

L. M. Pumpelly  
Notary Public.

My commission expires 8-24-71