

TYPE

AFFIDAVIT OF COMPLETION FORM

ACO-1 WELL HISTORY

SIDE ONE

Two (2) copies of this form shall be filed with the Kansas Corporation Commission, 200 Colorado Derby Building, Wichita, Kansas 67202, within thirty (30) days after the completion of a well, regardless of how the well was completed.

Attach separate letter of request if the information is to be held confidential. If confidential, only file one copy. Information on Side One will be of public record and Side Two will then be held confidential.

Applications must be made on dual completion, commingling, salt water disposal, injection and temporarily abandoned wells.

Attach one copy only wireline logs (i.e. electrical log, sonic log, gamma ray neutron log, etc.). (Rules 82-2-105 & 82-2-125) KCC# (316) 263-3238.

LICENSE # 5208 EXPIRATION DATE 6/30/83

OPERATOR Mobil Oil Corporation for Northern Natural API NO. 15-189-20582-0600

ADDRESS P. O. Box 5444 Gas Prod. Co. COUNTY Stevens

Denver, CO 80217 FIELD Panoma

** CONTACT PERSON C. J. Park, Prod. Acctg. Supv. PROD. FORMATION Council Grove

PHONE 303/572-2696

PURCHASER Northern Natural Gas Company LEASE Chaffin No. 2 Unit

ADDRESS 2223 Dodge Street WELL NO. 3

Omaha, Nebraska 68102 WELL LOCATION Sec. 22-32S-36W

DRILLING EARL F. Wakefield, Inc. 1250 Ft. from South Line and

CONTRACTOR 300 W. Douglass, Suite 500 1250 Ft. from West Line of

ADDRESS Wichita, Kansas 67202 the SW/4(Qtr.) SEC 22 TWP 32S RGE 36W.

PLUGGING CONTRACTOR ADDRESS

ADDRESS

TOTAL DEPTH 3140' PBTD -

SPUD DATE 6/4/82 DATE COMPLETED 6/29/82

ELEV: GR 3060.5 DF KB 3068.5


DRILLED WITH (CABLE) (ROTARY) (AIR) TOOLS.

DOCKET NO. OF DISPOSAL OR REPRESSURING WELL BEING USED TO DISPOSE OF WATER FROM THIS LEASE CD 117710

Amount of surface pipe set and cemented 596' DV Tool Used? No

THIS AFFIDAVIT APPLIES TO: (Circle ONE) - Oil, Gas, Shut-in Gas, Dry, Disposal, Injection, Temporarily Abandoned, OWWO. Other

ALL REQUIREMENTS OF THE STATUTES, RULES AND REGULATIONS PROMULGATED TO REGULATE THE OIL AND GAS INDUSTRY HAVE BEEN FULLY COMPLIED WITH.

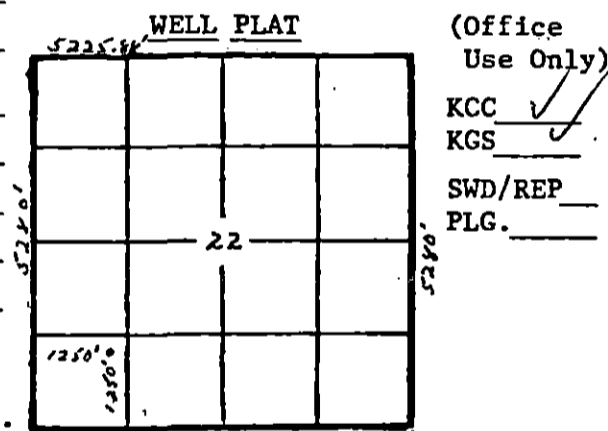

A F F I D A V I T

C. J. Park, being of lawful age, hereby certifies that:

I am the Affiant, and I am familiar with the contents of the foregoing Affidavit. The statements and allegations contained therein are true and correct.

C. J. Park (Name)

SUBSCRIBED AND SWORN TO BEFORE ME this 8 day of November, 1982.

Judith A. Allen (NOTARY PUBLIC) RECEIVED STATE CORPORATION COMMISSION

MY COMMISSION EXPIRES: 11-28-84

** The person who can be reached by phone regarding any questions concerning this information.

NOV 12 1982 CONSERVATION DIVISION Wichita, Kansas

