

STATE CORPORATION COMMISSION OF KANSAS  
OIL & GAS CONSERVATION DIVISION  
WELL COMPLETION OR RECOMPLETION FORM  
ACO-1 WELL HISTORY  
DESCRIPTION OF WELL AND LEASE

Operator: License # 5598  
Name APX Corporation  
Address P. O. Box 351  
City/State/Zip Liberal, Kansas 67905-0351

Purchaser Panhandle Eastern Pipe Line Co.  
(Transporter)

Operator Contact Person M. L. Pease  
Phone (316) 624-6253

Contractor: License # 5842  
Name Gabbert-Jones, Inc.

Wellsite Geologist NA  
Phone

Designate Type of Completion  
 New Well  Re-Entry  Workover  
 Oil  SWD  Temp Abd  
 Gas  Inj  Delayed Comp.  
 Dry  Other (Core, Water Supply etc.)

If OWWO: old well info as follows:  
Operator  
Well Name  
Comp. Date Old Total Depth


WELL HISTORY

Drilling Method:  
 Mud Rotary  Air Rotary  Cable  
10-1-88 10-3-88 10-31-88  
Spud Date Date Reached TD Completion Date  
2905 2897  
Total Depth PBTD  
Amount of Surface Pipe Set and Cemented at 527 feet  
Multiple Stage Cementing Collar Used? Yes  No  
If yes, show depth set feet  
If alternate 2 completion, cement circulated from feet depth to w/ SX cmt  
Cement Company Name Halliburton Services  
Invoice # 720682  
A I I

API NO. 15-189-21,265-0000  
County Stevens  
SE NE SE Sec. 27 Twp. 32S Rge. 38 East  
1390 Ft North from Southeast Corner of Section  
100 Ft West from Southeast Corner of Section  
(Note: Locate well in section plat below)

Lease Name Bradshaw "A" Well # 2H  
Field Name Hugoton  
Producing Formation Chase  
Elevation: Ground 3166.0 KB

Section Plat

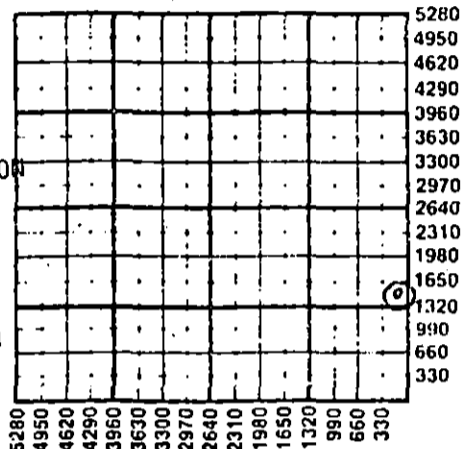

RECEIVED  
STATE CORPORATION COMMISSION  
JAN 17 1989  
CONSERVATION DIVISION  
Wichita, Kansas

WATER SUPPLY INFORMATION

Disposition of Produced Water:  Disposal  
Docket #  Repressuring

Questions on this portion of the ACO-1 call:  
Water Resources Board (913) 296-3717

Source of Water:  
Division of Water Resources Permit #  
 Groundwater Ft North from Southeast Corner  
(Well) Ft West from Southeast Corner of  
Sec Twp Rge East West  
 Surface Water Ft North from Southeast Corner  
(Stream, pond etc) Ft West from Southeast Corner  
Sec Twp Rge East West  
 Other (explain) Contractor provided water  
(purchased from city, R.W.D. #)


INSTRUCTIONS: This form shall be completed in triplicate and filed with the Kansas Corporation Commission, 200 Colorado Derby Building, Wichita, Kansas 67202, within 120 days of the spud date of any well. Rule 82-3-130, 82-3-107 and 82-3-106 apply. Information on side two of this form will be held confidential for a period of 12 months if requested in writing and submitted with the form. See rule 82-3-107 for confidentiality in excess of 12 months. One copy of all wireline logs and drillers time log shall be attached with this form. Submit CP-4 form with all plugged wells. Submit CP-111 form with all temporarily abandoned wells.

All requirements of the statutes, rules and regulations promulgated to regulate the oil and gas industry have been fully complied with and the statements herein are complete and correct to the best of my knowledge.

Signature M. L. Pease  
Title Division Production Manager Date 1/16/89

Subscribed and sworn to before me this 16th day of Jan 1989  
Notary Public Glenn S. Salley

Date Commission Expires

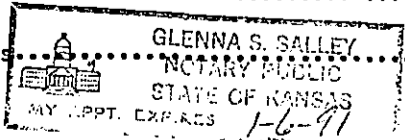

K.C.C. OFFICE USE ONLY  
 Letter of Confidentiality Attached  
 Wireline Log Received  
 Drillers Time Log Received  
Distribution:  KCC  SWD/Rep  NGPA  
 KGS  Plug  Other (Specify)  
1-17-89  
Form ACO-1 (5-86)

Sec 27 Twp 32S Rge 38E