SIDE ONE

STATE CORPORATION COMMISSION OF KANSAS
OIL & GAS CONSERVATION DIVISION
WELL COMPLETION OR RECOMPLETION FORM
ACO-1 WELL HISTORY
DESCRIPTION OF WELL AND LEASE

Operator: License # 5598
Name APX Corporation
Address P. O. Box 351
City/State/Zip Liberal, Kansas 67905-0351

Purchaser Panhandle Eastern Pipe Line Co. (Transporter)

Operator Contact Person M. L Pease
Phone (316) 624-6253

Contractor: License # 5842
Name Gabbert-Jones, Inc.

Wellsite Geologist NA
Phone

Designate Type of Completion
X New Well __ Re-Entry __ Workover

__ Oil __ SWD __ Temp Abd
X Gas __ Inj __ Delayed Comp.
__ Dry __ Other (Core, Water Supply etc.)

If OWWO: old well info as follows:
Operator
Well Name
Comp. Date Old Total Depth

WELL HISTORY

Drilling Method:
X Mud Rotary __ Air Rotary __ Cable

7/9/88	7/12/88	9/16/88
Spud Date	Date Reached TD	Completion Date

2910	2898
Total Depth	PBTD

Amount of Surface Pipe Set and Cemented at 558 feet
Multiple Stage Cementing Collar Used? __ Yes X No
If yes, show depth set feet
If alternate 2 completion, cement circulated
from feet depth to w/ SX cmt
Cement Company Name Halliburton Services
Invoice # 769657

AIT-I

API NO. 15- 189-21,214-0000

County Stevens

NW NW SE SW Sec. 27 Twp. 32S Rge. 38 __ East X West

1250 Ft North from Southeast Corner of Section
3890 Ft West from Southeast Corner of Section
(Note: Locate well in section plat below)

Lease Name Patrick "A" Well # 1H

Field Name Hugoton INFILL

Producing Formation Chase

Elevation: Ground 3182.9 KB

Section Plat

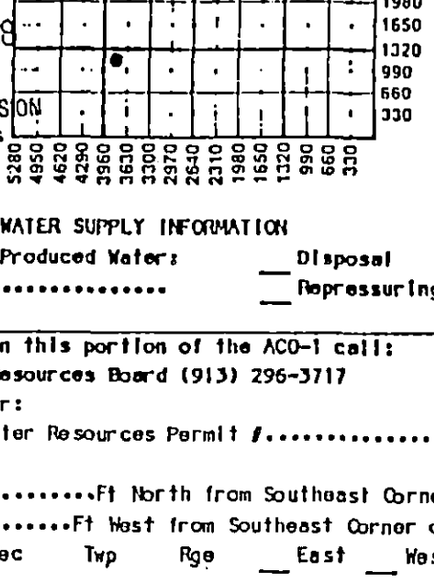

RECEIVED
STATE CORPORATION COMMISSION
NOV 7 1988
CONSERVATION DIVISION
Wichita, Kansas

WATER SUPPLY INFORMATION
Disposition of Produced Water: __ Disposal
Docket # __ Repressuring

Questions on this portion of the ACO-1 call:
Water Resources Board (913) 296-3717
Source of Water:
Division of Water Resources Permit #

__ Groundwater Ft North from Southeast Corner
(Well) Ft West from Southeast Corner of
Sec Twp Rge __ East __ West

__ Surface Water Ft North from Southeast Corner
(Stream, pond etc) Ft West from Southeast Corner
Sec Twp Rge __ East __ West

X Other (explain) Contractor provided water
(purchased from city, R.W.D. #)

INSTRUCTIONS: This form shall be completed in triplicate and filed with the Kansas Corporation Commission, 200 Colorado Derby Building, Wichita, Kansas 67202, within 120 days of the spud date of any well. Rule 82-3-130, 82-3-107 and 82-3-106 apply.
Information on side two of this form will be held confidential for a period of 12 months if requested in writing and submitted with the form. See rule 82-3-107 for confidentiality in excess of 12 months.
One copy of all wireline logs and drillers time log shall be attached with this form. Submit CP-4 form with all plugged wells. Submit CP-111 form with all temporarily abandoned wells.

All requirements of the statutes, rules and regulations promulgated to regulate the oil and gas industry have been fully complied with and the statements herein are complete and correct to the best of my knowledge.

Signature M. L. Pease
M. L Pease
Title Division Production Manager Date 11/3/88

Subscribed and sworn to before me this 3rd day of Nov.
19 88
Notary Public Glenna S. Dalton
GLENNA S. DALTON
NOTARY PUBLIC
MY APPT. EXPIRES 1-6-91
Date Commission Expires

K.C.C. OFFICE USE ONLY
F Letter of Confidentiality Attached
C Wireline Log Received
C Drillers Timelog Received
Distribution
KCC __ SWD/Rep __ NGPA
KGS __ Plug Other (Specify)
11-7-88

Sec 27 Twp 32 Rge 38W