


STATE OF KANSAS  
STATE CORPORATION COMMISSION

Give All Information Completely  
Make Required Affidavit  
Mail or Deliver Report to:  
Conservation Division  
State Corporation Commission  
212 No. Market  
Wichita, Kansas

WELL PLUGGING RECORD

Stevens County, Sec. 10 Twp. 34S Rge. (E) 39 (W)

Location as "NE/CNW/SE/SW" or footage from lines  
Lease Owner Stevens County Oil and Gas Company  
Lease Name Jenkins Well No. 1  
Office Address 302 American Savings Bldg.  
Character of Well (completed as Oil, Gas or Dry Hole) Gas  
Date well completed 19 31  
Application for plugging filed March 27 19 70  
Application for plugging approved March 27 19 70  
Plugging commenced April 22 19 70  
Plugging completed April 25 19 70  
Reason for abandonment of well or producing formation replaced by new well

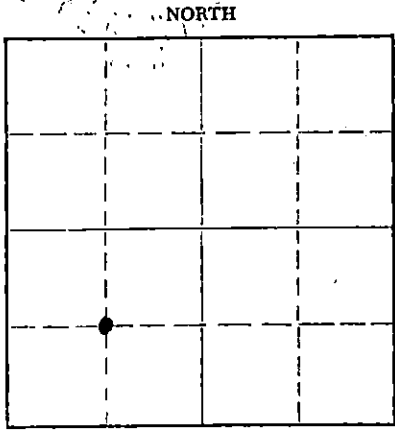

Locate well correctly on above Section Plat

If a producing well is abandoned, date of last production April 19 69  
Was permission obtained from the Conservation Division or its agents before plugging was commenced? Yes

Name of Conservation Agent who supervised plugging of this well Mr. Edgar J. Eves  
Producing formation Depth to top Bottom Total Depth of Well unknown Feet  
Show depth and thickness of all water, oil and gas formations.

OIL, GAS OR WATER RECORDS

CASING RECORD

FORMATION	CONTENT	FROM	TO	SIZE	PUT IN	PULLED OUT
				8 5/8"	2580	1215'

Describe in detail the manner in which the well was plugged, indicating where the mud fluid was placed and the method or methods used in introducing it into the hole. If cement or other plugs were used, state the character of same and depth placed, from feet to feet for each plug set.

Spotted 85 sacks cement at 2395'. Spotted 65 sacks cement from 500' to 400'.

Spotted 15 sacks cement from 25' to surface. Hole filled with mud between plugs.

RECEIVED  
STATE CORPORATION COMMISSION  
MAY 6 1970  
CONSERVATION DIVISION  
Wichita, Kansas

(If additional description is necessary, use BACK of this sheet)

Name of Plugging Contractor Sargent's Casing Pulling Service  
Address Box 506, Liberal, Kansas 67901


STATE OF Kansas, COUNTY OF Sedgewick, ss.  
W. Mike Adams (employee of owner) or (owner or operator) of the above-described well, being first duly sworn on oath, says: That I have knowledge of the facts, statements, and matters herein contained and the log of the above-described well as filed and that the same are true and correct. So help me God.

(Signature) W. Mike Adams

(Address)

Subscribed and sworn to before me this 5th day of May, 1970

Helen Riley  
Notary Public

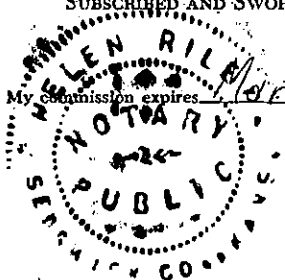

15-189-00668-0000

W.L.SIDWELL OIL & GAS COMPANY

JENKINS #1-10

<u>Date</u>	<u>Time</u>	<u>Ave.Pres.</u>	<u>Hours</u>	<u>Extention</u>	<u>M.Cu.Ft.Gas</u>
Dec. 4th.	4 P.M.	350	16	1451	779
" 5	8 A.M.	350	24	1985	1066
" 6	8 A.M.	350	24	2046	1093
" 7	8 A.M.	342	24	2549	1369
" 8	11 A.M.	350	27	2741	1472
" 9	11 A.M.	368	24	2217	1190
" 10	11 A.M.	383	24	2185	1173
" 11	11 A.M.	394	22	1772	951
" 12	9 A.M.	373	23	1838	987
" 13	10 A.M.	380	24	2051	1101
" 14	9 A.M.	380	5	386	207
" 21	12, 20 PM	370	9	788	423
" 21		372	24	2042	1096
" 22	9 A.M.	370	24	2123	1140

14,052 M. .05 \$702.60

W.L.Sidwell Oil & Gas Co.	10/24	\$256.15
Oskaloosa Syndicate	8/24	204.93
Howard Kuhn	3/24	76.85
Walter Kuhr	3/24	76.84
Ollie Jenkins	1/8 R	87.83
		<hr/>
		702.60

*Cancelled in late 1931-*

RECEIVED  
STATE CORPORATION COMMISSION  
MAR 31 1970  
CONSERVATION DIVISION  
Wichita, Kansas

Gas Units operated by The Stevens County O&G Co.  
Stevens County, Kansas

Jenkins Unit - Section 10-34-39

- Drilled depth not known
- Drilled & completed in 1931

- Equipment-2,580 ft 6 5/8" I.D. Seamless ( Cemented )
  - 8 1/2 X 7" Swedge
  - 1-7" Orbit Gate Valve
  - 1-7" X 12 Nipple
  - 1-2 X 12 Nipple
  - 1 X 12 Nipple
  - 1-1" Murco Valve # 142
  - 1-2" Murco Valve

-Workover - June, 1955

- Only able to open hole to depth of 2595 ft.

*L. Kerr*