

15-129-003440000


STATE OF KANSAS
STATE CORPORATION COMMISSION

WELL PLUGGING RECORD

Give All Information Completely
Make Required Affidavit
Mail or Deliver Report to:
Conservation Division
State Corporation Commission
800 Bitting Building
Wichita, Kansas

Morton County, Sec. 9 Twp. 34 Rge. 30 (W)
Location as "NE/CNW $\frac{1}{4}$ SW $\frac{1}{4}$ " or footage from lines Center SE $\frac{1}{4}$
Lease Owner Sidwell, et al
Lease Name Snare Well No. 1
Office Address 202 Wheeler-Kelly-Hagney Bldg., Wichita, Kansas
Character of Well (completed as Oil, Gas or Dry Hole) Gas
Date well completed August 1930
Application for plugging filed March 27, 1953 19
Application for plugging approved March 27, 1953 19
Plugging commenced April 15, 1953 19
Plugging completed April 20, 1953 19
Reason for abandonment of well or producing formation Pipe deteriorated allowing water to enter casing & caused shut-off of flow of
If a producing well is abandoned, date of last production 19 gas
Was permission obtained from the Conservation Division or its agents before plugging was commenced? Yes

NORTH

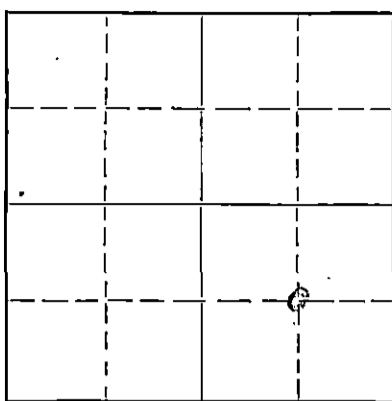

Locate well correctly on above
Section Plat

Name of Conservation Agent who supervised plugging of this well R. J. Phillipe
Producing formation Depth to top Bottom Total Depth of Well 2790 Feet
Show depth and thickness of all water, oil and gas formations.

OIL, GAS OR WATER RECORDS

CASING RECORD

Formation	Content	From	To	Size	Put In	Pulled Out

Describe in detail the manner in which the well was plugged, indicating where the mud fluid was placed and the method or methods used in introducing it into the hole. If cement or other plugs were used, state the character of same and depth placed, from feet to feet for each plug set.

Halliburton pumped a plug to the top of the 5 1/2" liner at 2620'. Put in 37' of rock and calseal. Ran 5 1/2" string of casing. The casing stopped at 2526' and was unable to get the 5 1/2" any lower so cemented it there with 150 sacks of cement. Plug circulated on the 5 1/2" before cementing and it circulated with water. After cement was in, either the bridge gave away or the 7" casing burst below 2526' allowing all the cement to go to the bottom of the hole cementing it completely solid. Halliburton ran temperature survey which showed the cement to be behind the 5 1/2" string of casing to 1760'. McCullough Tool Company shot the 5 1/2" off at 1710'. Pumped the hole full of mud. Did not pull any 7" casing or surface pipe. Welded top of 10" surface casing after it was completely full of mud.

RECEIVED
STATE CORPORATION COMMISSION
MAY - 2 1953
5-2-1953
CONSERVATION DIVISION
WICHITA, KANSAS

(If additional description is necessary, use BACK of this sheet)

Name of Plugging Contractor Walter Kuhn
Address 403 Union National Bank Building, Wichita, Kansas

STATE OF Kansas, COUNTY OF Sedgewick, ss.
Walter Kuhn (employee of owner) or (owner or operator) of the above-described well,

being first duly sworn on oath, says: That I have knowledge of the facts, statements, and matters herein contained and the log of the above-described well as filed and that the same are true and correct. So help me God.

(Signature) Walter Kuhn
403 Union National Bank Building
Wichita, Kansas (Address)

SUBSCRIBED AND SWORN to before me this 29th day of May, 1953, 19

My commission expires December 16, 1954. Notary Public.

23-8390-s 6-51-20M

PLUGGING
FILE SEC 9 T 34 R 390
BOOK PAGE 12 LINE 40