

15-129-20002-0000

WELL PLUGGING RECORD

File All Information Completely
Make Required Affidavit
Mail or Deliver Report to:
Conservation Division
State Corporation Commission
211 No. Broadway
Wichita, Kansas

Morton County. Sec. 32 Twp. 34S Rge. 41 ~~600~~ (W)

Location as "NE/CNW/SW" or footage from lines 660' S, 1980' W of SW

Lease Owner Cities Service Oil Company

Lease Name Gyr "B" Well No. 1

Office Address Box 1028, Guymon, Oklahoma

Character of Well (completed as Oil, Gas or Dry Hole) Dry hole

Date well completed 3-6-67 1967

Application for plugging filed 3-6-67 1967

Application for plugging approved 3-8-67 1967


Plugging commenced 3-6-67 1967

Plugging completed 3-10-67 1967

Reason for abandonment of well or producing formation Dry hole

If a producing well is abandoned, date of last production _____ 19____

Was permission obtained from the Conservation Division or its agents before plugging was commenced? Yes

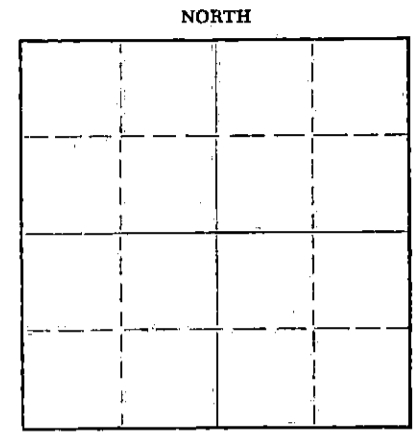

Locate well correctly on above Section Plat

Name of Conservation Agent who supervised plugging of this well Hugh Scott

Producing formation _____ Depth to top _____ Bottom _____ Total Depth of Well 5116 Feet

Show depth and thickness of all water, oil and gas formations.

OIL, GAS OR WATER RECORDS CASING RECORD

FORMATION	CONTENT	FROM	TO	SIZE	PUT IN	PULLED OUT
Morrow S-3	Dry	5023	5116	8 5/8"	1460	None

Describe in detail the manner in which the well was plugged, indicating where the mud fluid was placed and the method or methods used in introducing it into the hole. If cement or other plugs were used, state the character of same and depth placed, from _____ feet to _____ feet for each plug set.

Cement plugs spotted as follows: 25 sxs. from 5002' to 5100', 25 sxs. from 4742' to 4840', 25 sxs. from 3207' to 3305', 25 sxs. from 3002' to 3100', 35 sxs. from 552' to 700' and 15 sxs. from 45' to 4' below ground level at which point the 8 5/8" casing was cut off and a steel cap welded on top.

RECEIVED
STATE CORPORATION COMMISSION
MAR 15 1967
3-15-1967
CONSERVATION DIVISION
WICHITA, KANSAS

(If additional description is necessary, use BACK of this sheet)

Name of Plugging Contractor Halliburton

Address Duncan, Oklahoma

STATE OF OKLAHOMA, COUNTY OF TEXAS, ss.

I, H. E. Massey (employee of owner) or (owner or operator) of the above-described well, being first duly sworn on oath, says: That I have knowledge of the facts, statements, and matters herein contained and the log of the above-described well as filed and that the same are true and correct. So help me God.

(Signature) H. E. Massey - Dist. Supt. *H. E. Massey*

Box 1028, Guymon, Oklahoma
(Address)

SUBSCRIBED AND SWORN TO before me this 14th day of March, 1967

My commission expires 5-4-70

Gloyd L. Shockley
Gloyd L. Shockley Notary Public.